


T. 21 S. R. 4 W. W.M.

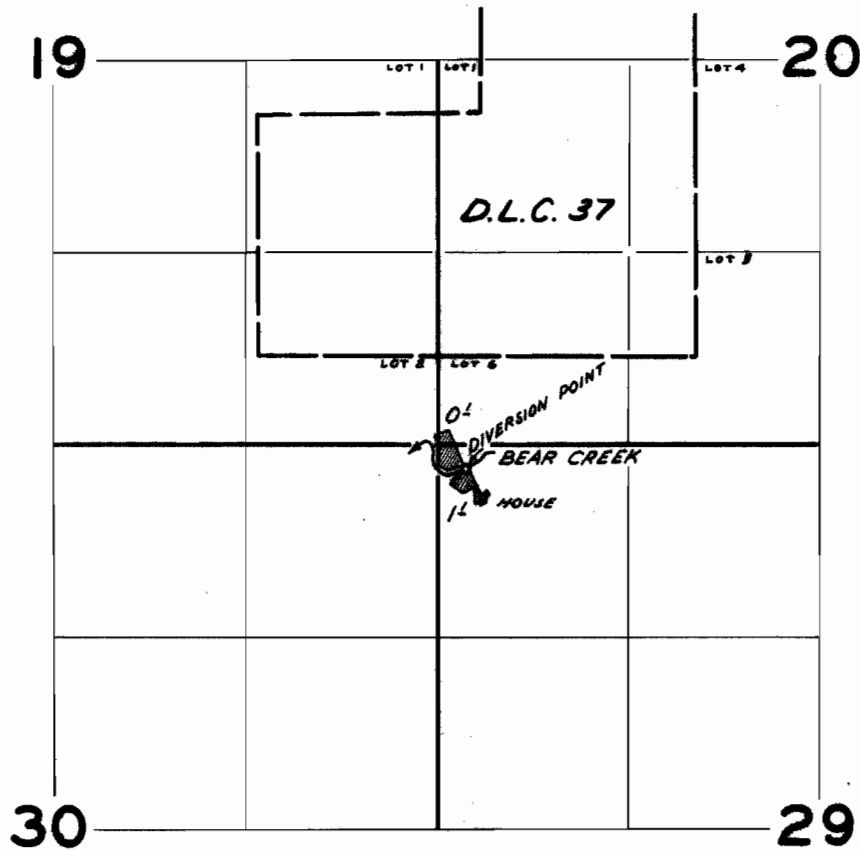

**FINAL PROOF SURVEY**  
UNDER

Application No. 37552 Permit No. 28033

IN NAME OF

IRENE D. AMES

Surveyed JUN 5 1963, by T. LAUER