


T. 10 S.R. 4 W.W.M.

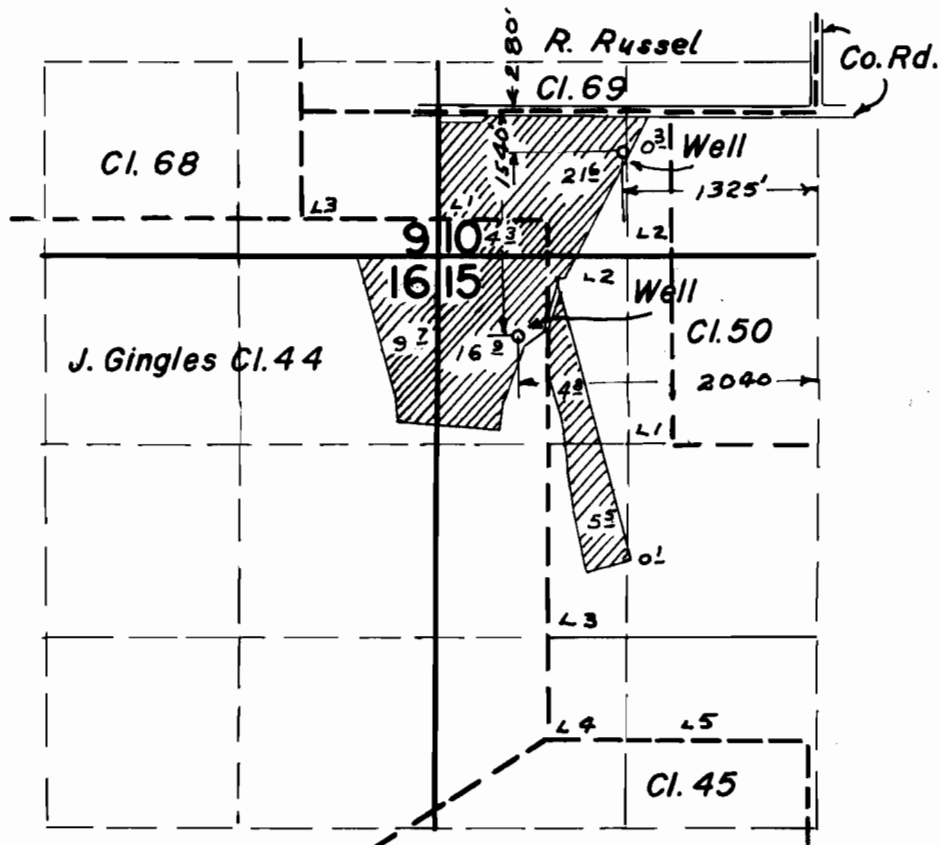

FINAL PROOF SURVEY
UNDER

Application No. *G-2539* Permit No. *G-2351*
IN NAME OF

George Ambrosek & Kenneth Holmes

Surveyed *July 19, 1965*, by *F. Siegmund*