


T. 10S. R. 6W. W.M.

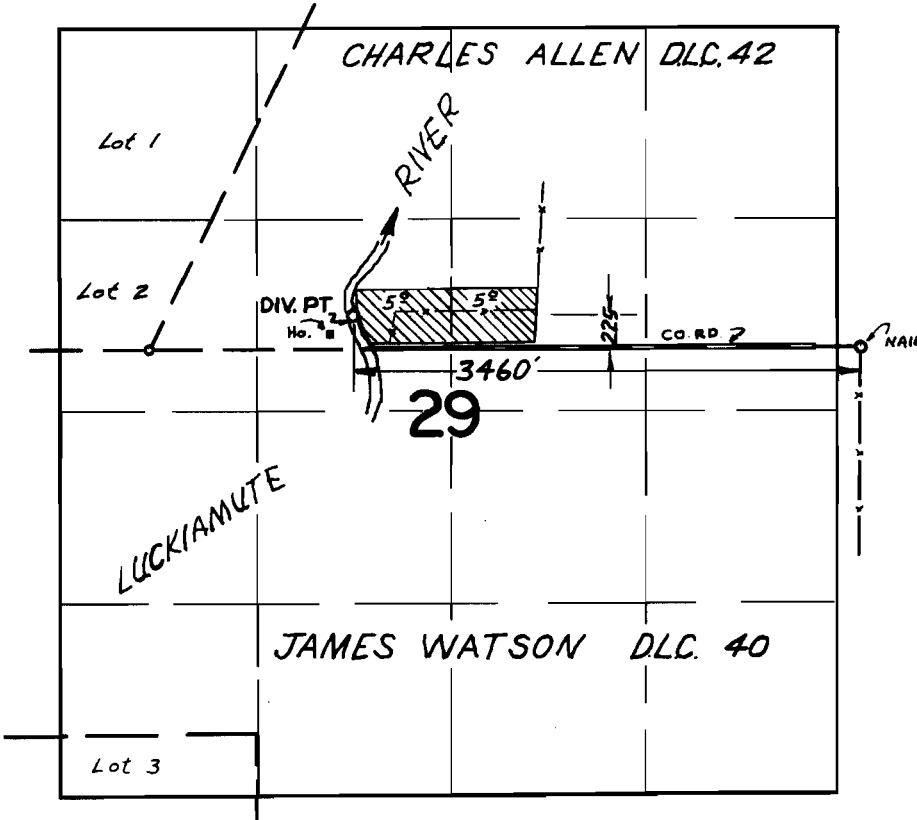

**FINAL PROOF SURVEY**  
UNDER

Application No. 37486... Permit No. 27906...  
IN NAME OF

.....GRACEN L. BUSH.....

Surveyed APRIL 8, 1966, by V. GARNER.....