


T. 12S. R. 58 & 6 W. W. M.

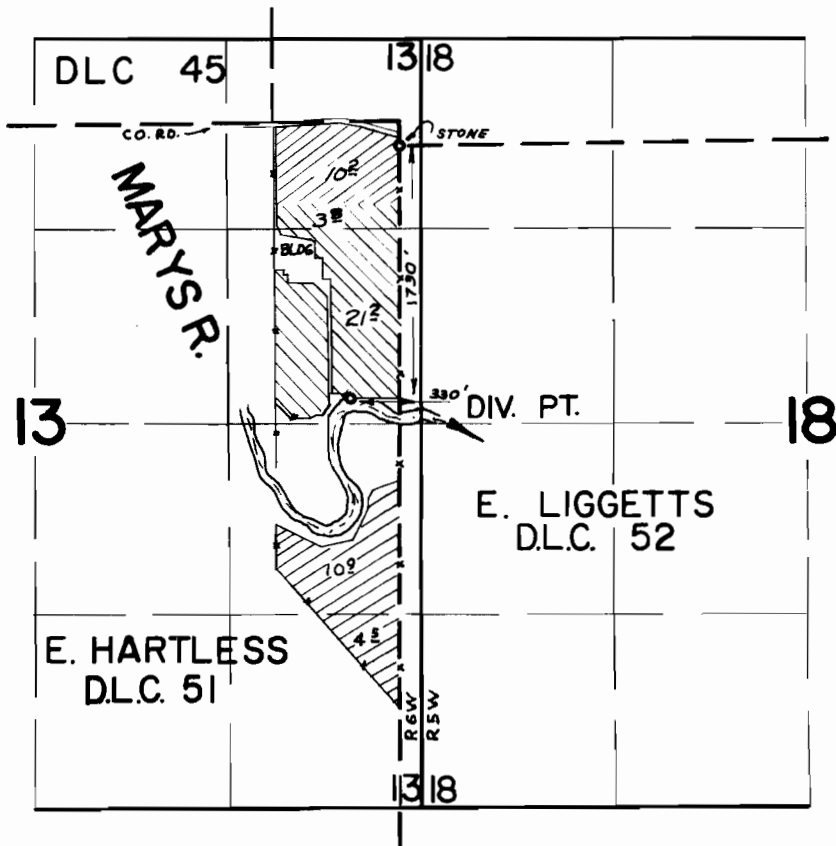

FINAL PROOF SURVEY
UNDER

Application No. 37 455 Permit No. 27 885 
Application No. 40414 Permit No. 30130 
IN NAME OF

GILBERT FAXON

Surveyed APRIL 6, 1966, by *V. Garner*