


T.11 S. R.7 W.W.M.

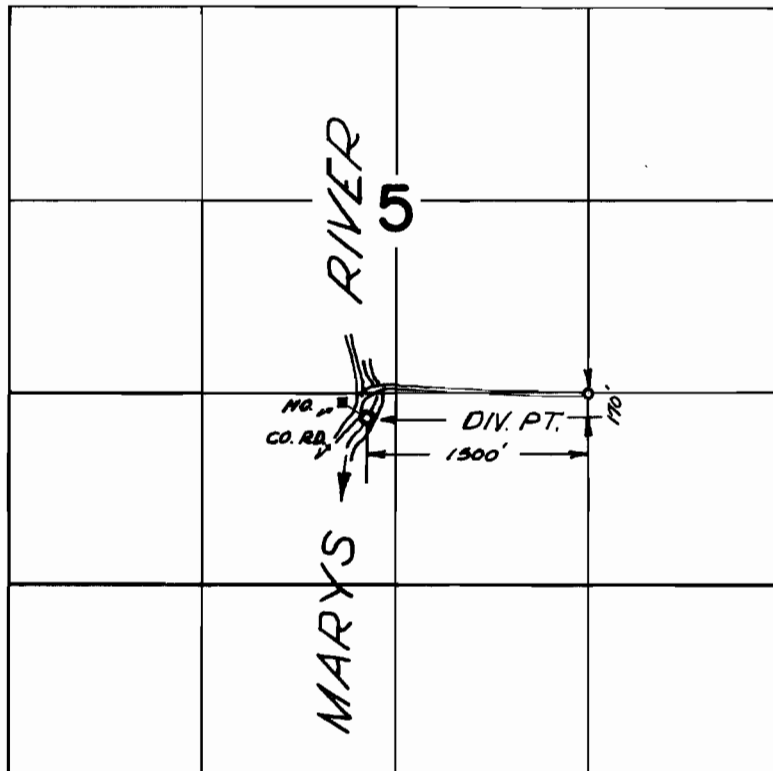

FINAL PROOF SURVEY
UNDER

Application No. 38960 Permit No. 29035
IN NAME OF

MRS. F. S. FRANSWAY

Surveyed April 11, 1966, by V. GARNER