


# T. 13 S. R. 5 W. W. M.

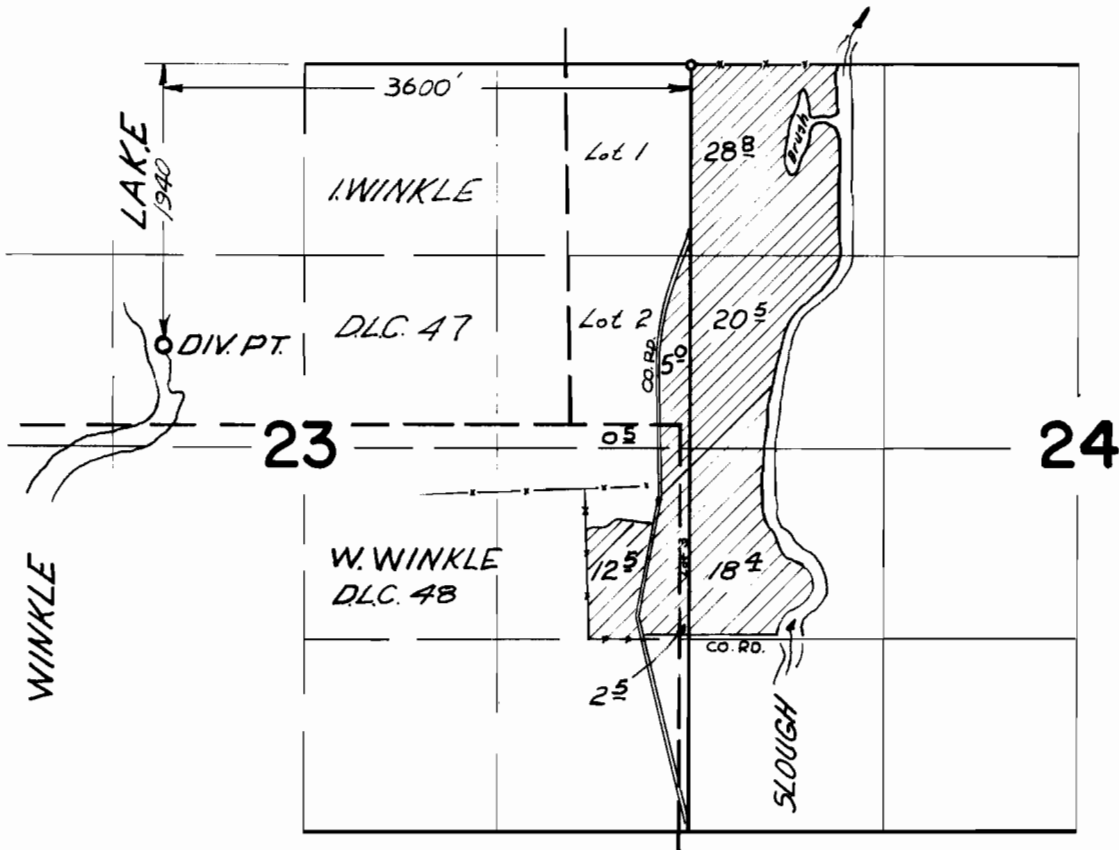

## FINAL PROOF SURVEY UNDER

Application No. 37654. Permit No. 28069  
IN NAME OF

C. E. MILLER

Surveyed April 22 19.66, by V. GARNER

DFJ-3P 21  
DFJ-3P-46  
PT 1966-A