


T.13 S. R.5 W.W.M.

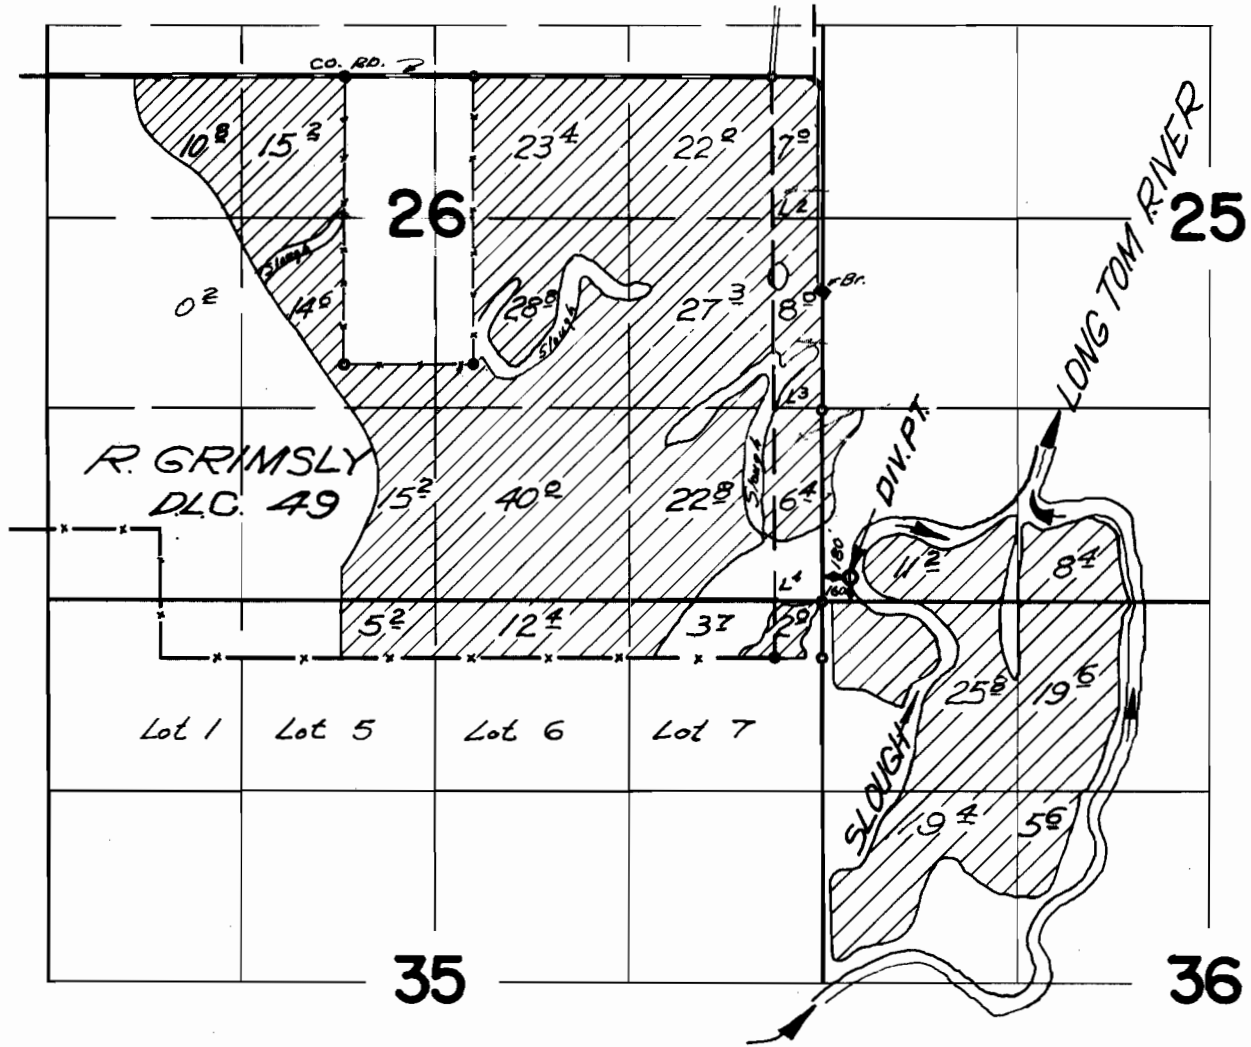

FINAL PROOF SURVEY
UNDER

Application No. 37655 Permit No. 28070
IN NAME OF

C. E. MILLER

Surveyed APRIL 22 1966, by V. GARNER

DFJ-3P-21
DFJ-3P-46
PT-1966-A