


T. 10S. R. 3 W.W.M.

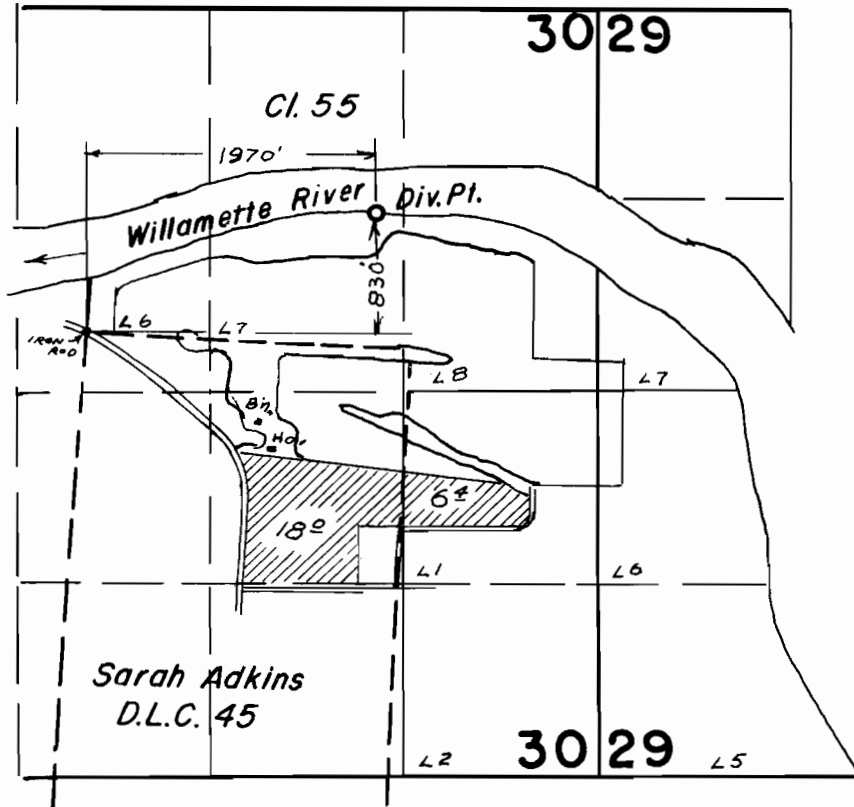

FINAL PROOF SURVEY
UNDER

Application No. 34666 Permit No. 27226
IN NAME OF

Harry A. Nelson

Surveyed July 16, 1965, by F. Siegmund