


T.5S. R.2E. W.M.

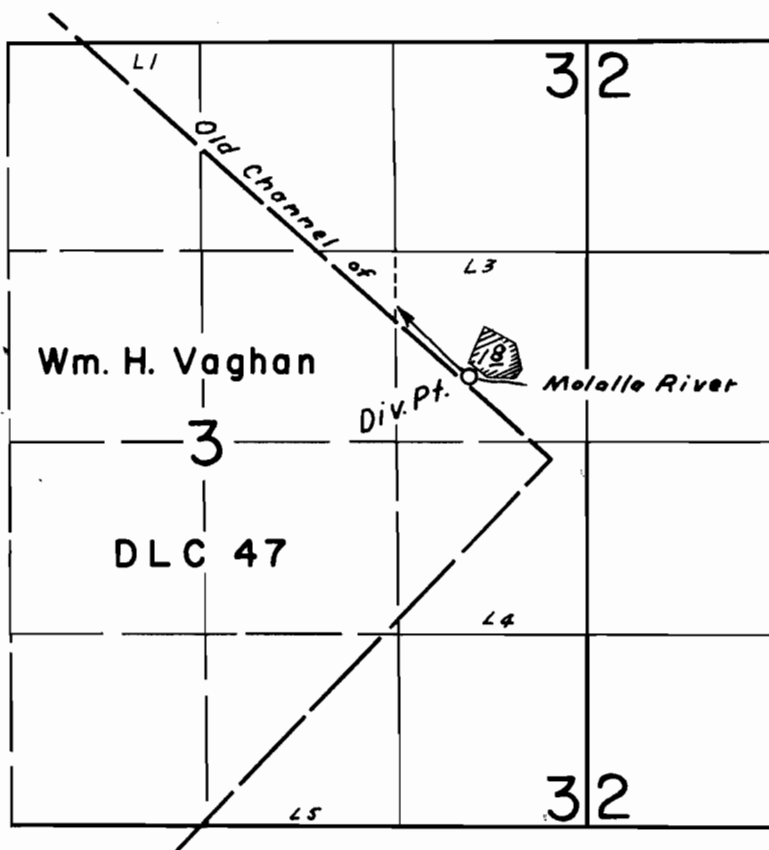

FINAL PROOF SURVEY
UNDER

Application No. 32657 Permit No. 25753
IN NAME OF

CARL McCALLY

Surveyed July 21, 1964, by C. J. Gardner