


T. 28 S. R. 12 W. W.M.

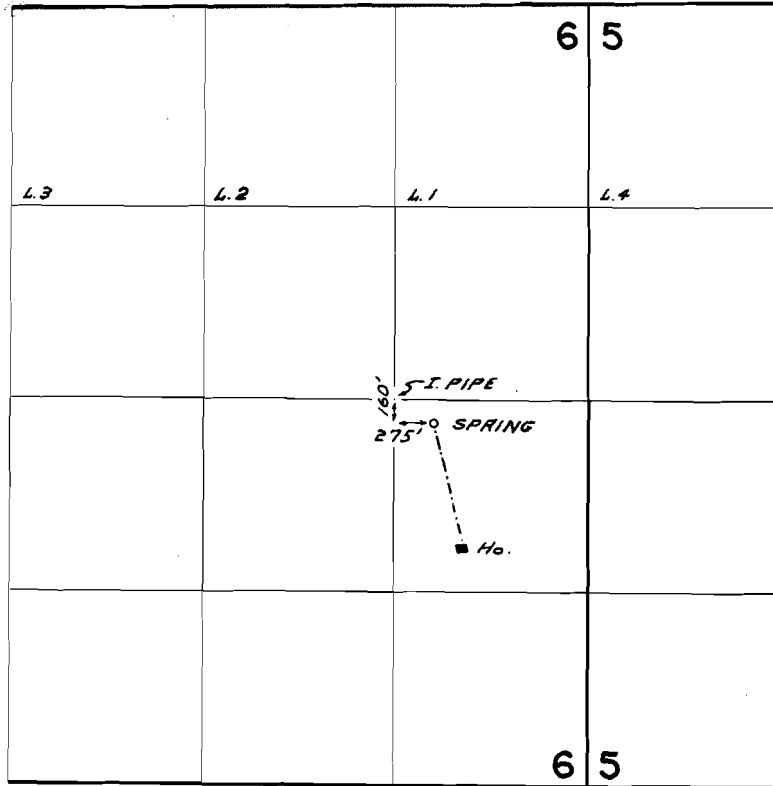

**FINAL PROOF SURVEY**  
UNDER

Application No. 40117 Permit No. 29909  
IN NAME OF

JAMES N. & EVELYN CROWLEY

Surveyed SEPT. 3 1965 by L. COLEBANK