


T.29S. R.12W. W.M.

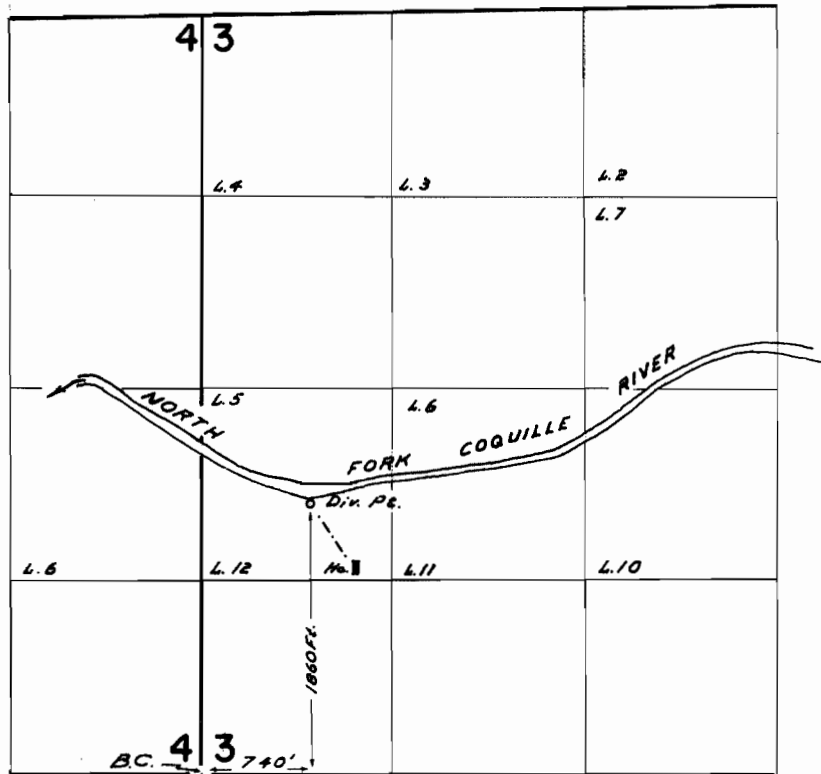

**FINAL PROOF SURVEY**  
UNDER

Application No. 39825 Permit No. 29593  
IN NAME OF

DELBERT J. LEEP

Surveyed SEPT 2 1965, by L. COLEBANK