


T.29S. R.12W. W.M.

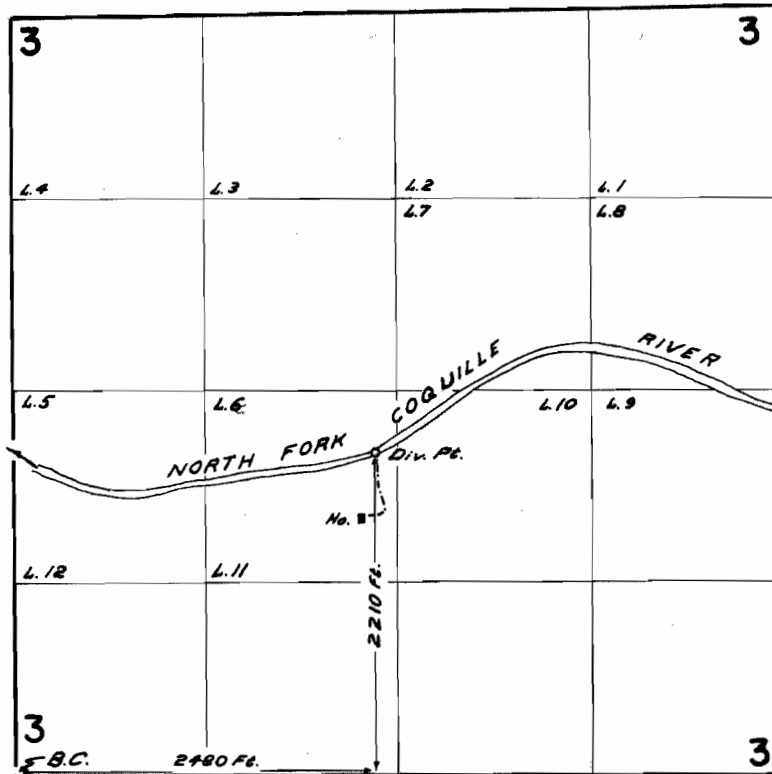

**FINAL PROOF SURVEY**  
UNDER

Application No. 39663 Permit No. 29527  
IN NAME OF

HOWARD LEE RODGERS

Surveyed SEPT. 2, 1965, by L. COLEBANK

1965 V. 210