


T.28S. R.13W. W.M.

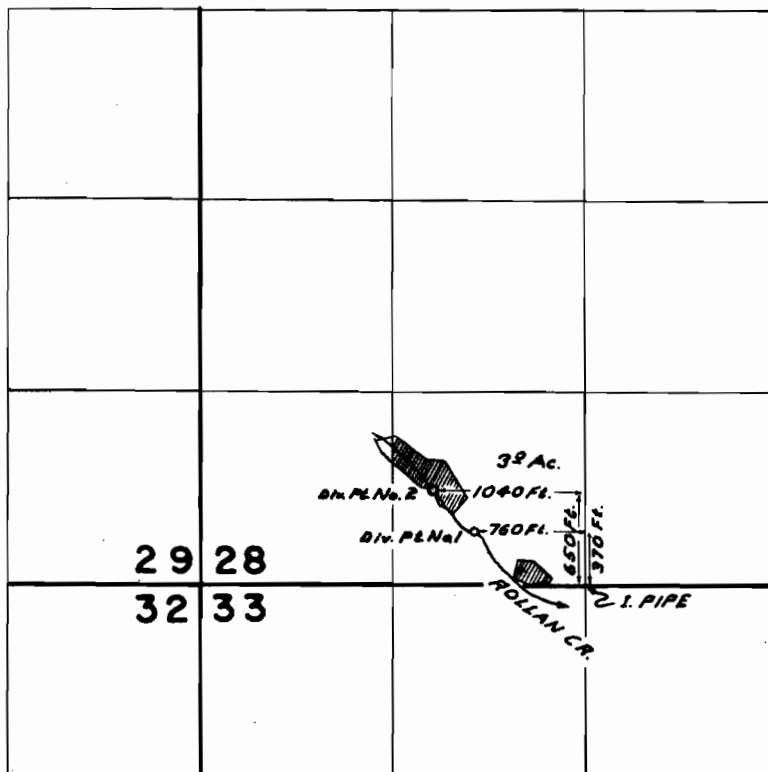

FINAL PROOF SURVEY
UNDER

Application No. 40294 Permit No. 30053
IN NAME OF

THOMAS H. & NONA THRIFT

Surveyed AUG 27 1965, by L. COLEBANK