

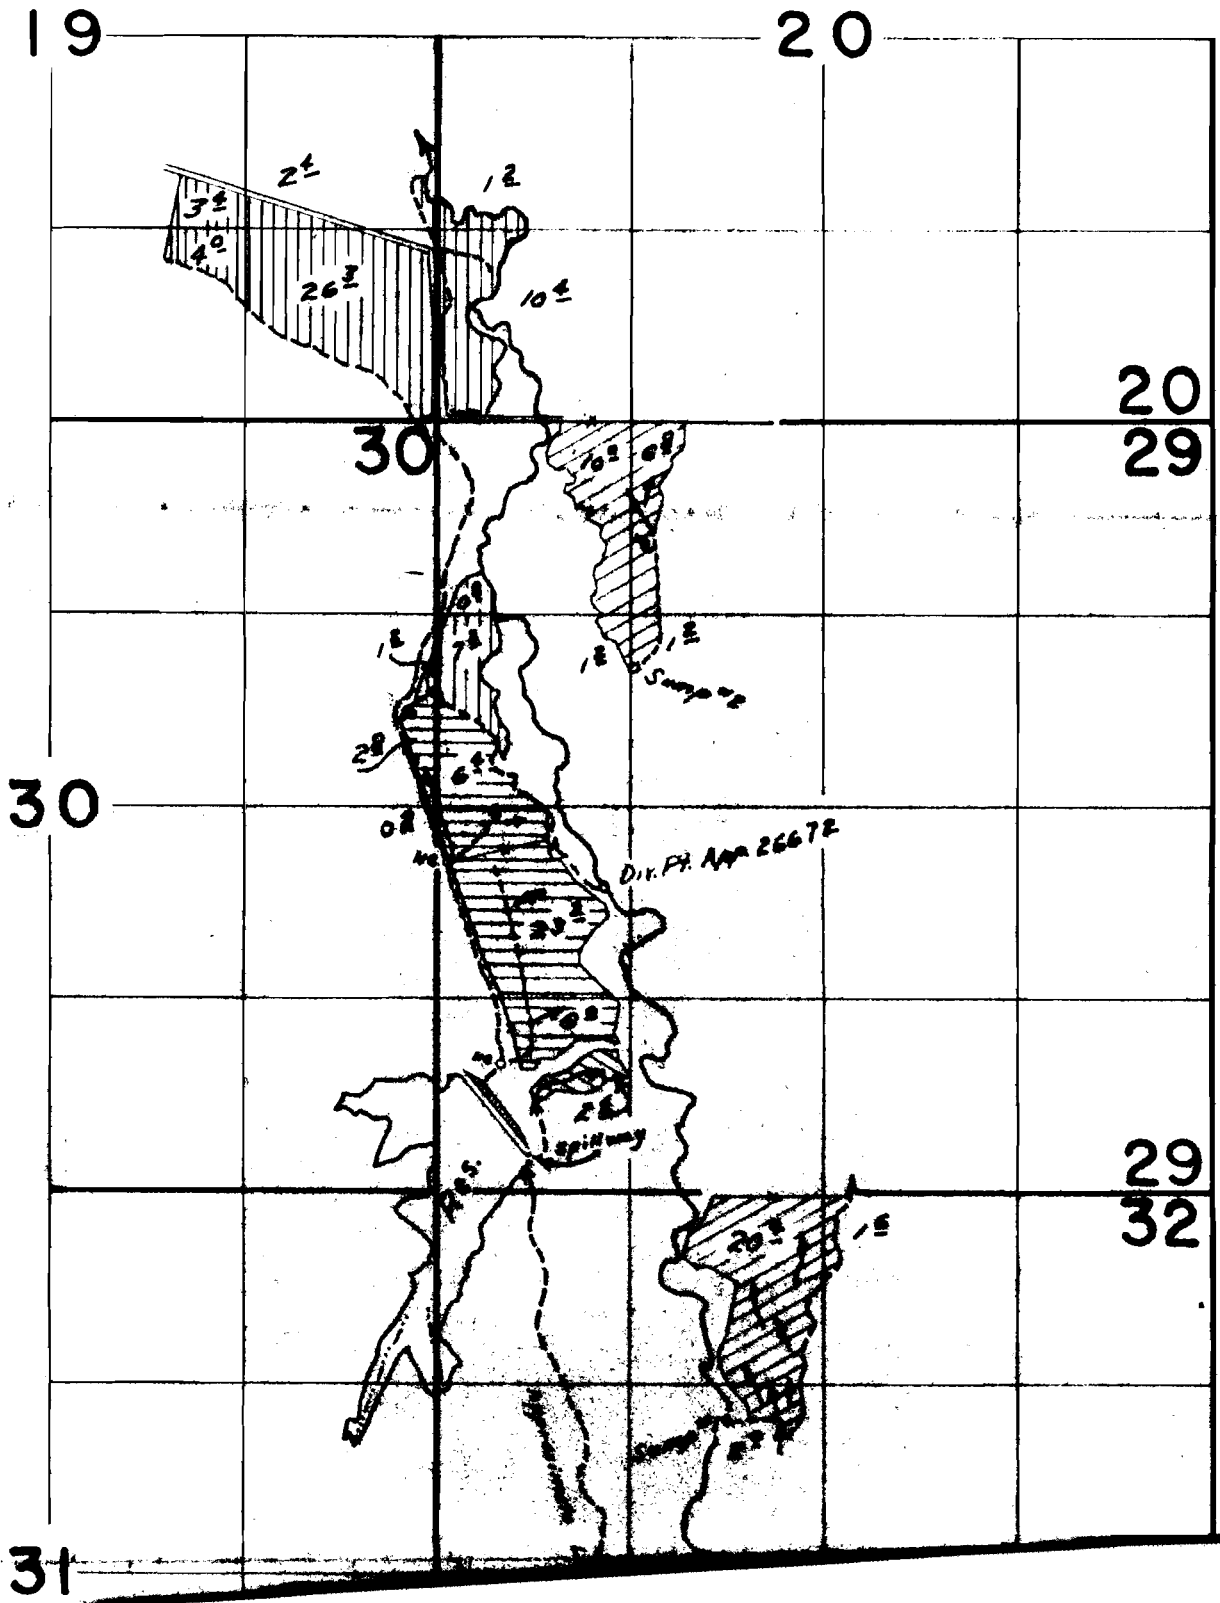


T.16&17S. R.25E.W.M.

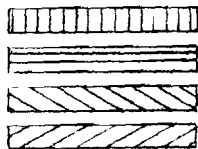

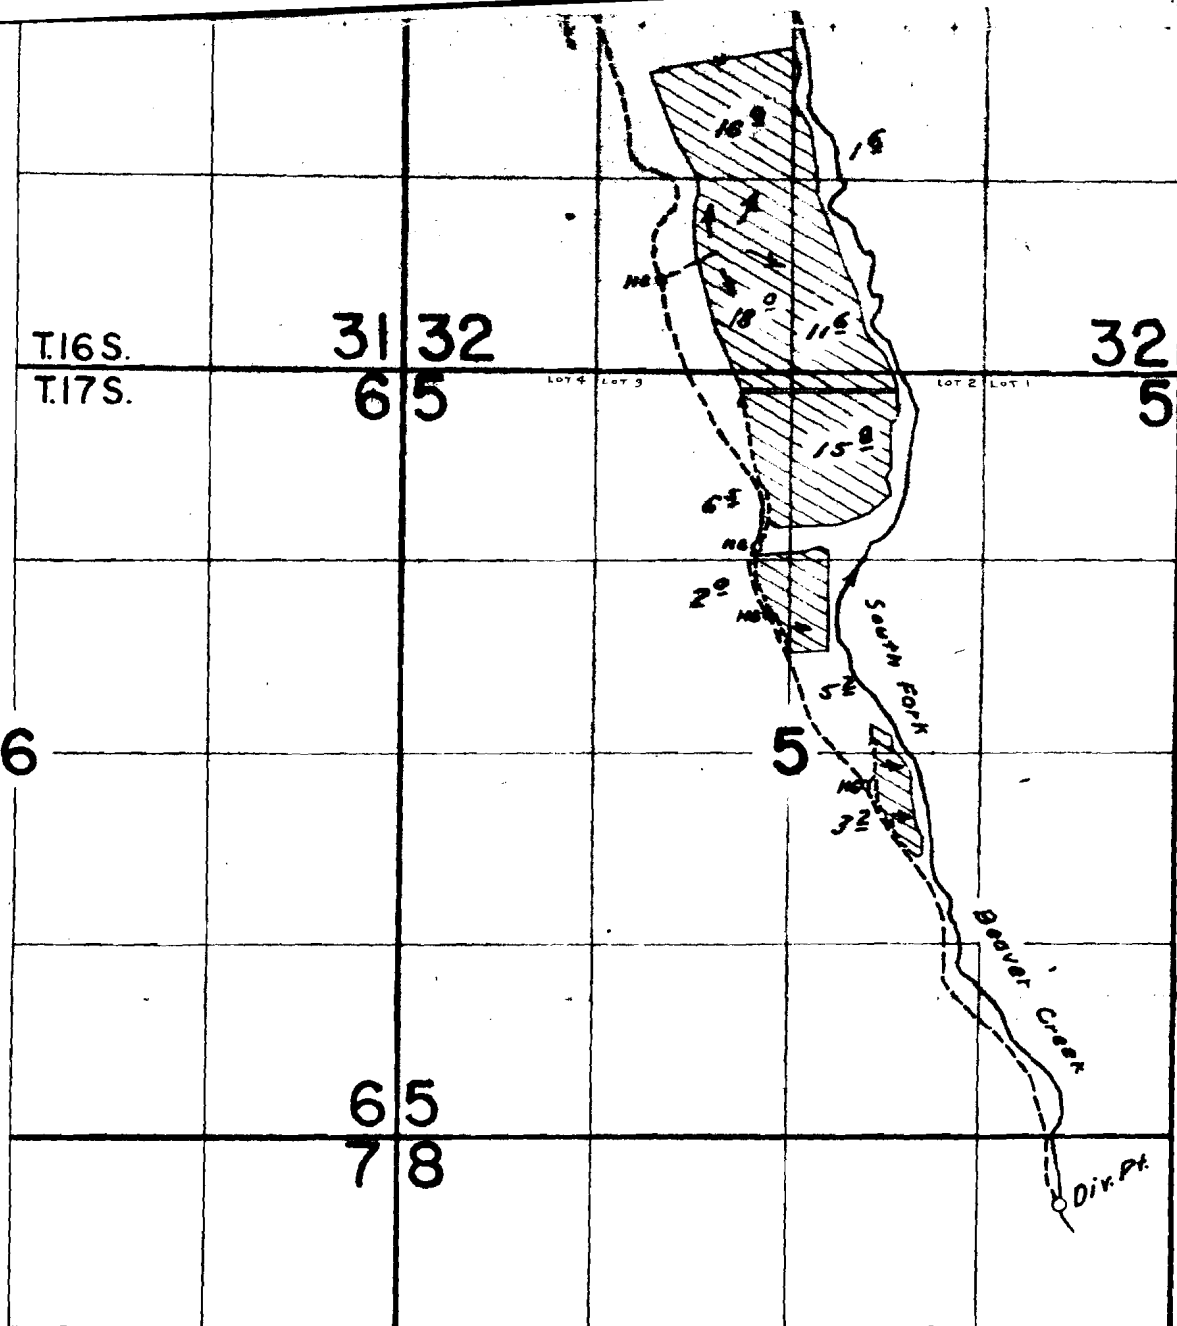

Supplemental to App. 26672

Stored and Direct Flow

Direct Flow

App. G-1995

FINAL PROOF SURVEY UNDER

Application No. ³²⁸⁷⁹ R-32878 ²⁶⁰⁰⁷ R-2224
 App. G-1995 Permit No. G-1852
 IN NAME OF

VERNON W. PALMER

Surveyed Oct. 3, 5, 6, 7 1964 by R. Jackson