
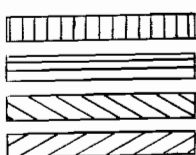


T.16&17S. R.25E.W.M.

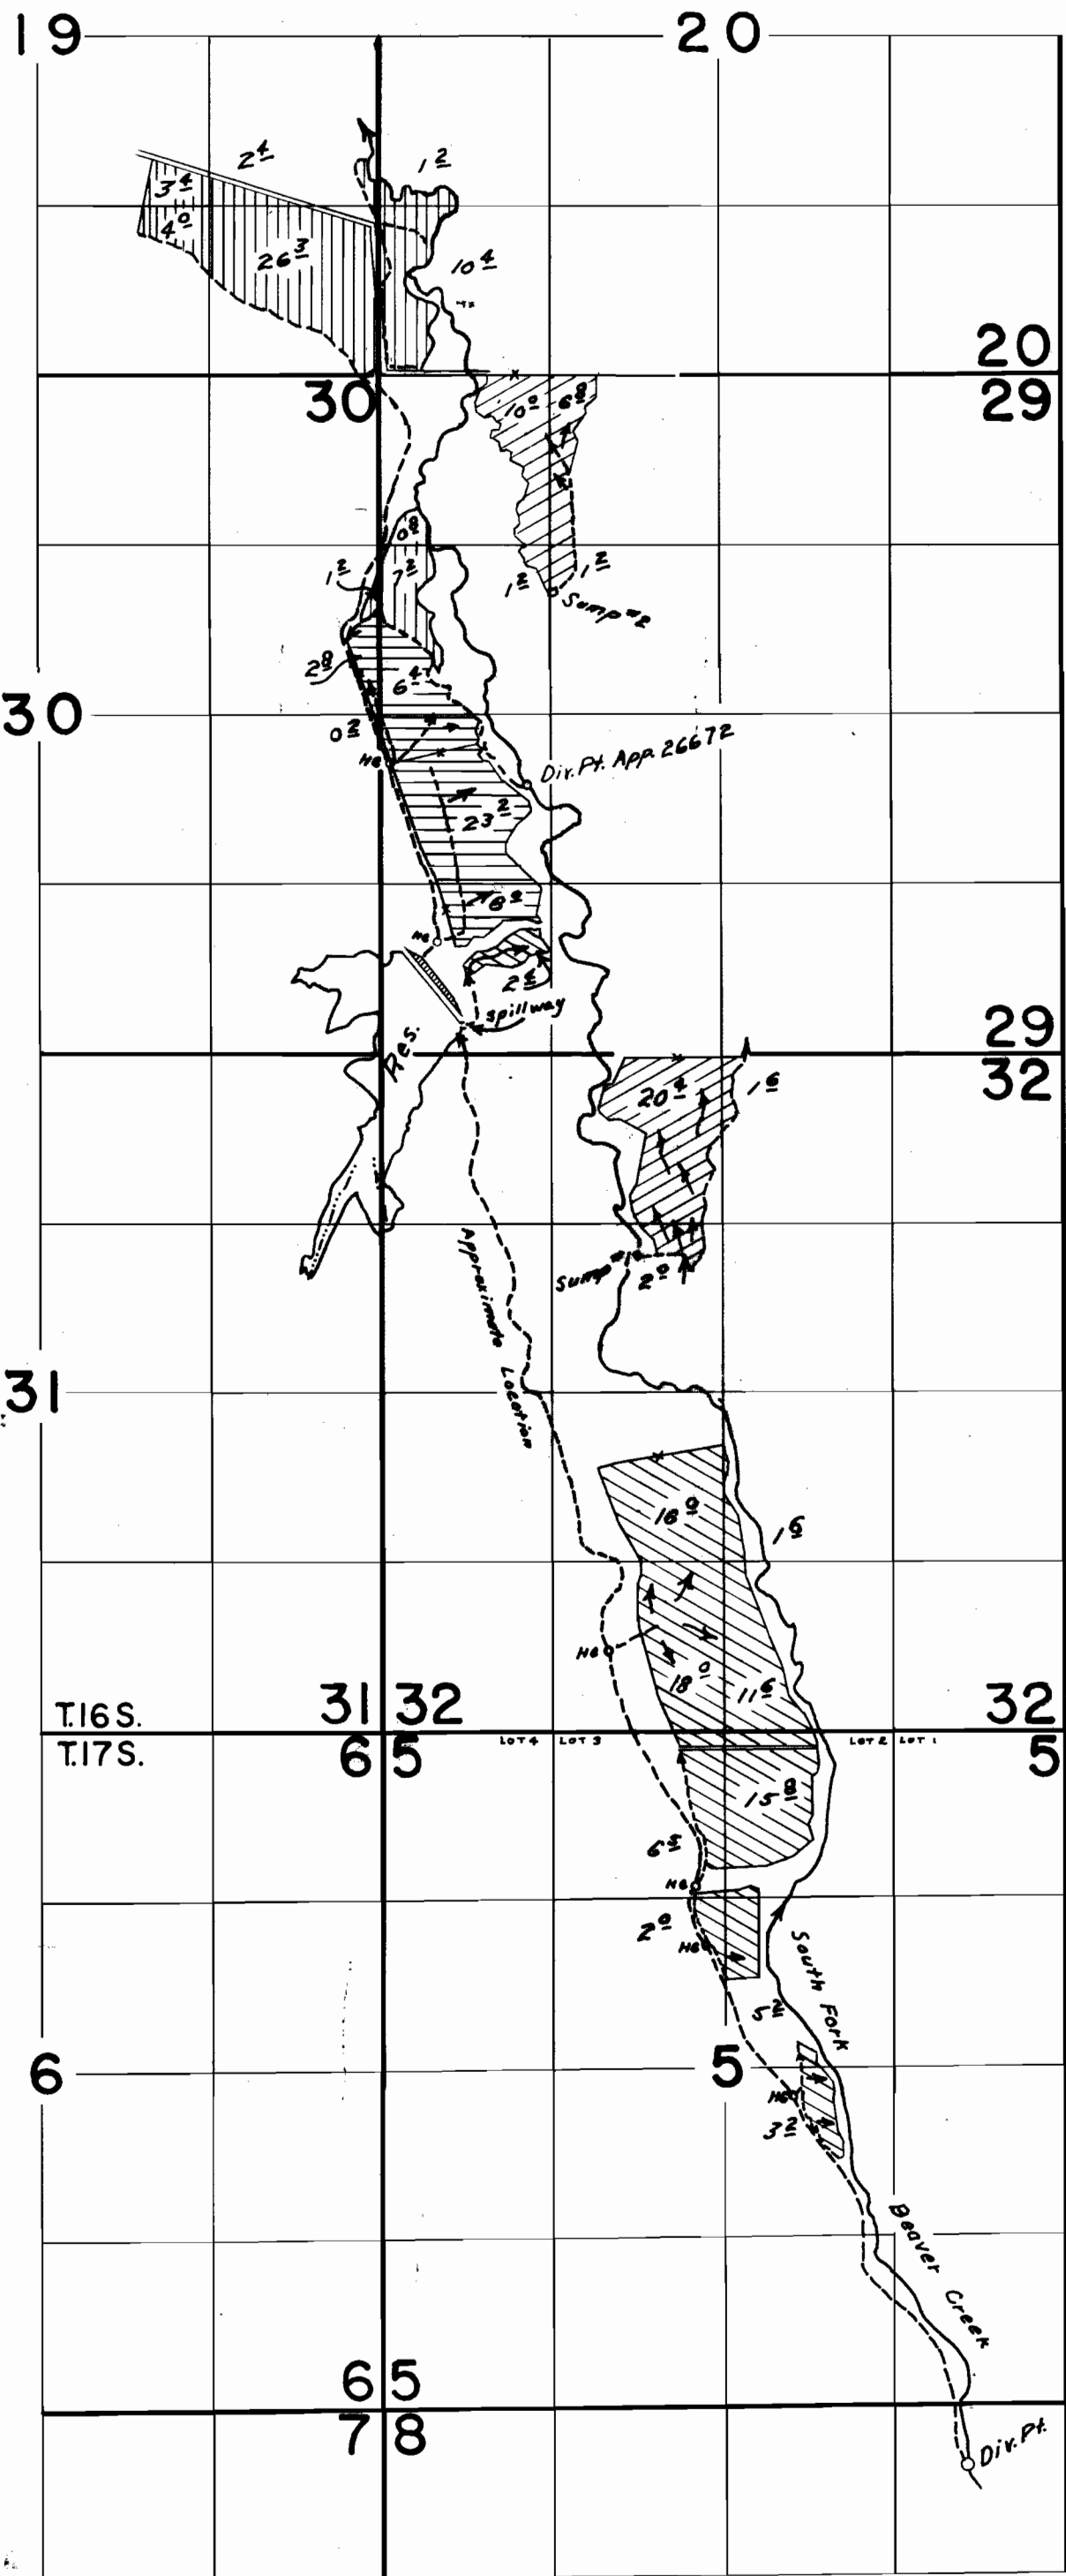

Supplemental to App. 26672  
 Stored and Direct Flow  
 Direct Flow  
 App. G-1995

**FINAL PROOF SURVEY**  
 UNDER

32879 26007  
 R-32878 R-2224  
 Application No. G-1995 Permit No. G-1852  
 IN NAME OF

**VERNON W. PALMER**

Surveyed Oct. 3, 5, 6, 7 1964 by R. Jackson