


T. 27S. R. 2W. W.M.

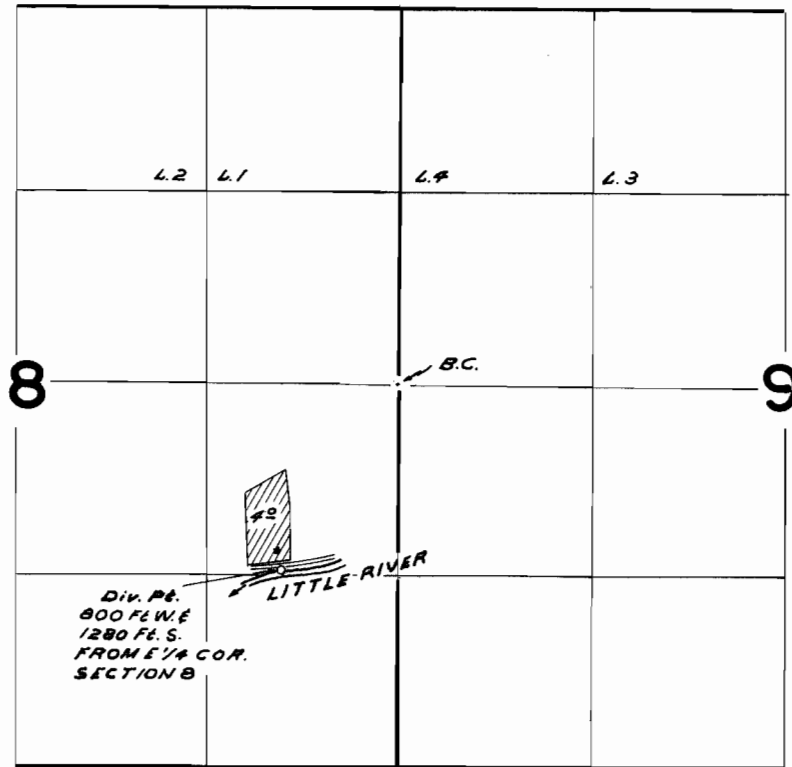

**FINAL PROOF SURVEY**  
UNDER

Application No. 37600 Permit No. 28041  
IN NAME OF

**GOTTFRIED FRANK & EMMY M. BERGER**

Surveyed OCT. 28 1965, by L. COLEBANK