


T.27S. R.2&3W. W.M

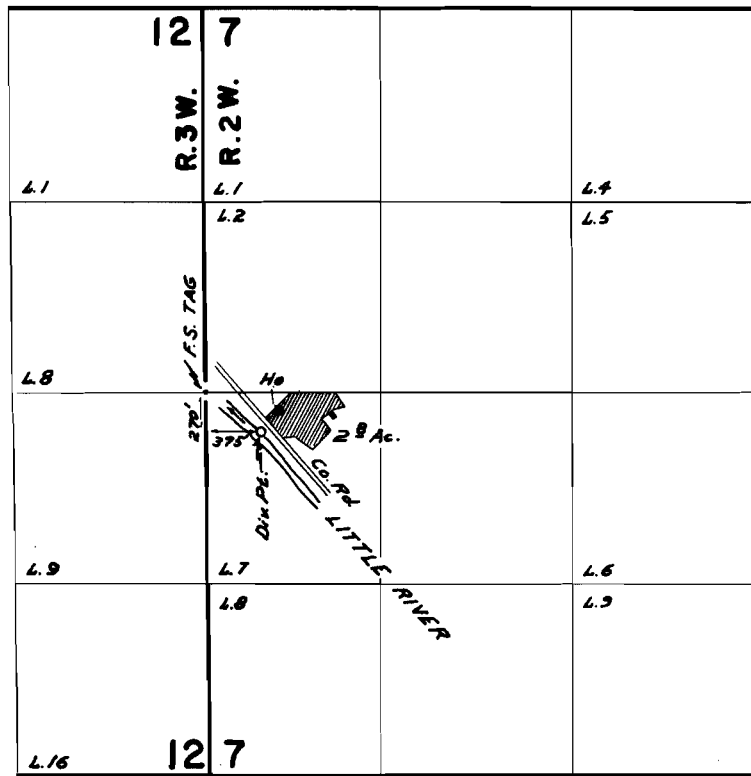

FINAL PROOF SURVEY UNDER

Application No. 40821 Permit No. 30413
IN NAME OF

WILLIAM. D. CLARDY

Surveyed OCT 28 1965, by L. COLEBANK