


T. 27S. R. 3W. W.M.

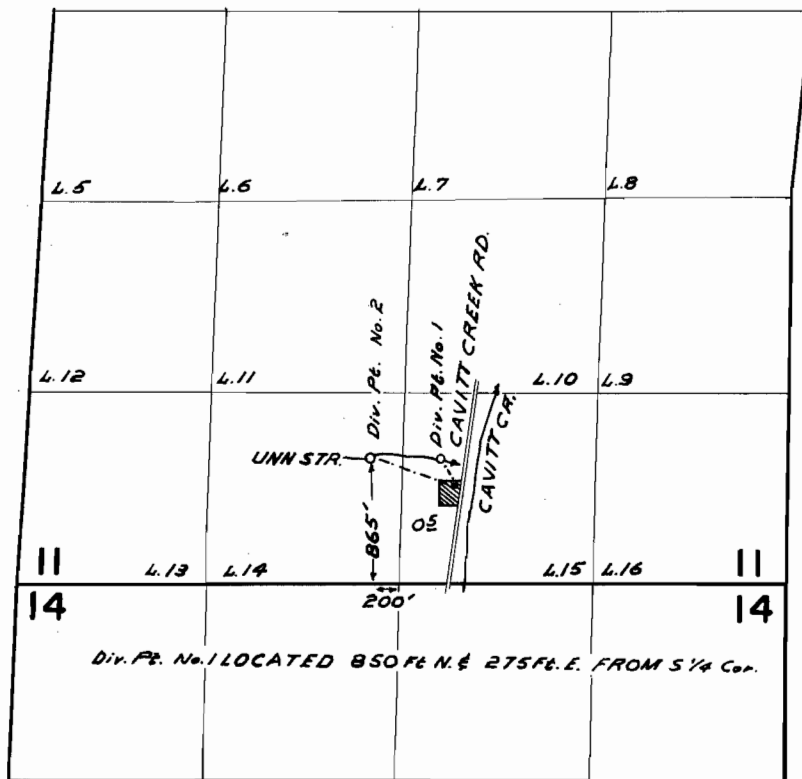

FINAL PROOF SURVEY
UNDER

Application No. 30912 Permit No. 25226
IN NAME OF

W. H. DAMEWOOD

Surveyed AUG 12, 1965, by L. COLEBANK.