


T. 27S. R. 4 & 5 W.W.M.

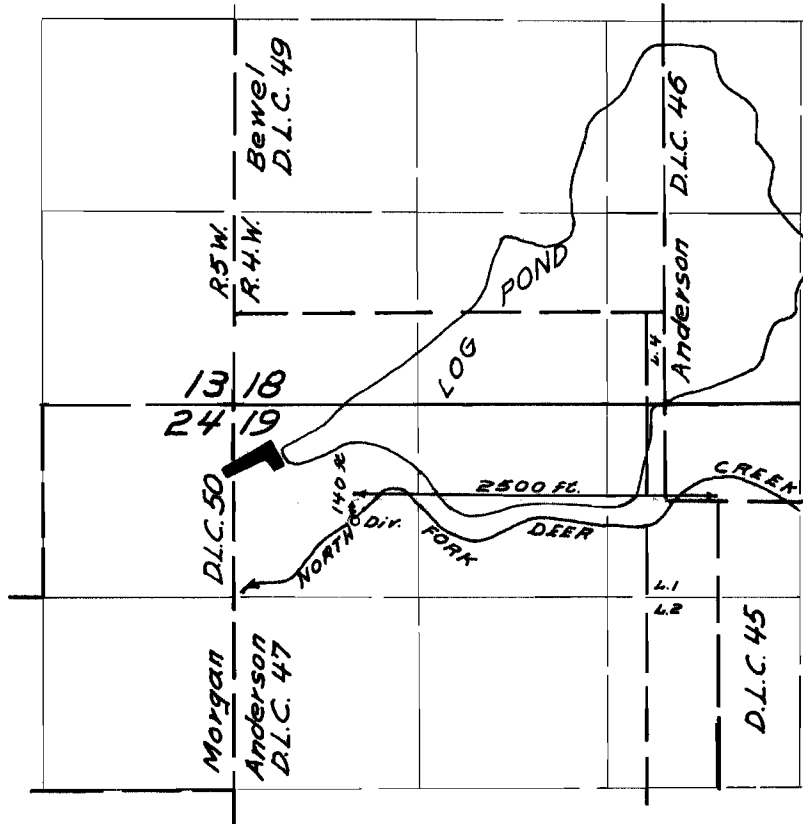

FINAL PROOF SURVEY
UNDER

Application No. 39252 Permit No. 29346
IN NAME OF

Douglas Veneer Co.

Surveyed Aug 11, 1965, by L.M. Colebank