


T.26S. R.4W. W.M.

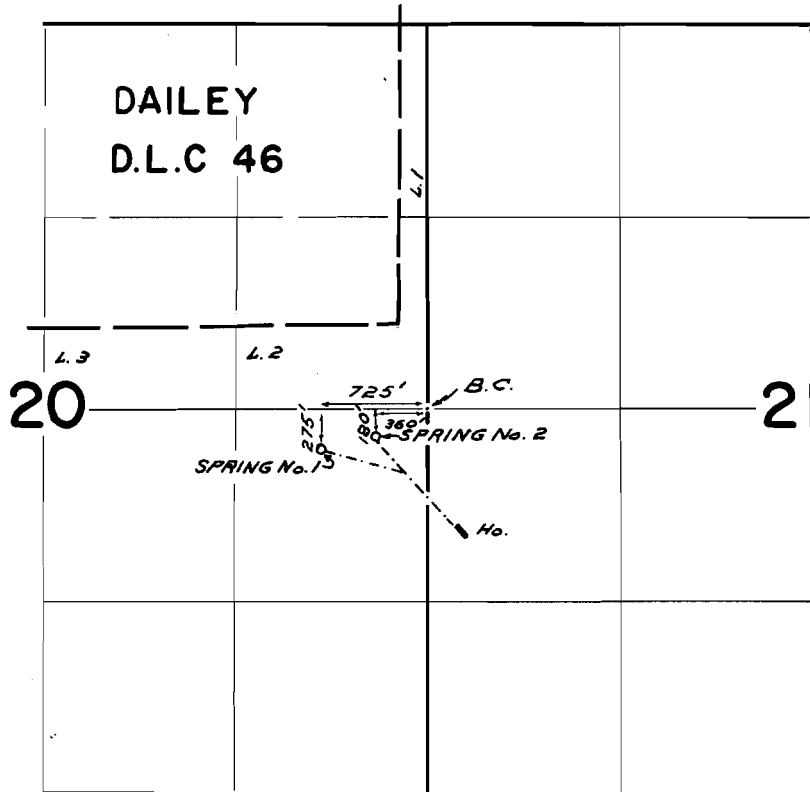

FINAL PROOF SURVEY
UNDER

Application No. 40122 Permit No. 29911
IN NAME OF

WAYNE D. MOSHER

Surveyed OCT. 25, 1965, by L. COLEBANK