


T.27S. R.4W. W.M.

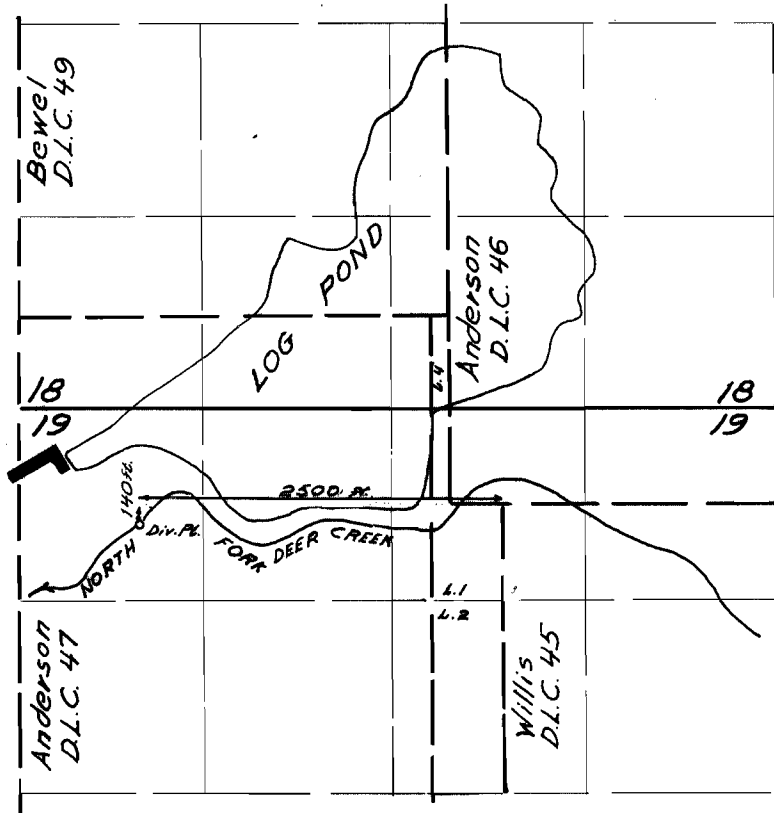

FINAL PROOF SURVEY
UNDER

Application No. 39253 Permit No. 29347
IN NAME OF

Richard C. Stratford, Trustee

Surveyed Aug 11, 1965, by L.M. Colebank