


T.26S. R.3W. W.M.

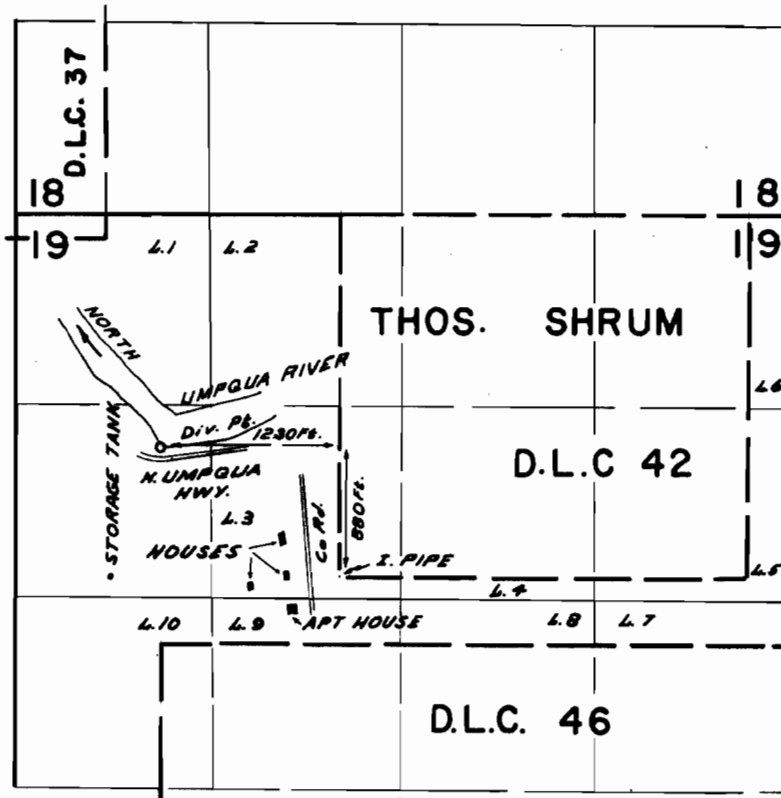

FINAL PROOF SURVEY
UNDER

Application No. 34862... Permit No. 27363...
IN NAME OF

JAMES V. ROMINE

Surveyed OCT. 29 1965, by L. COLEBANK