


T.27S.R.5W. W.M.

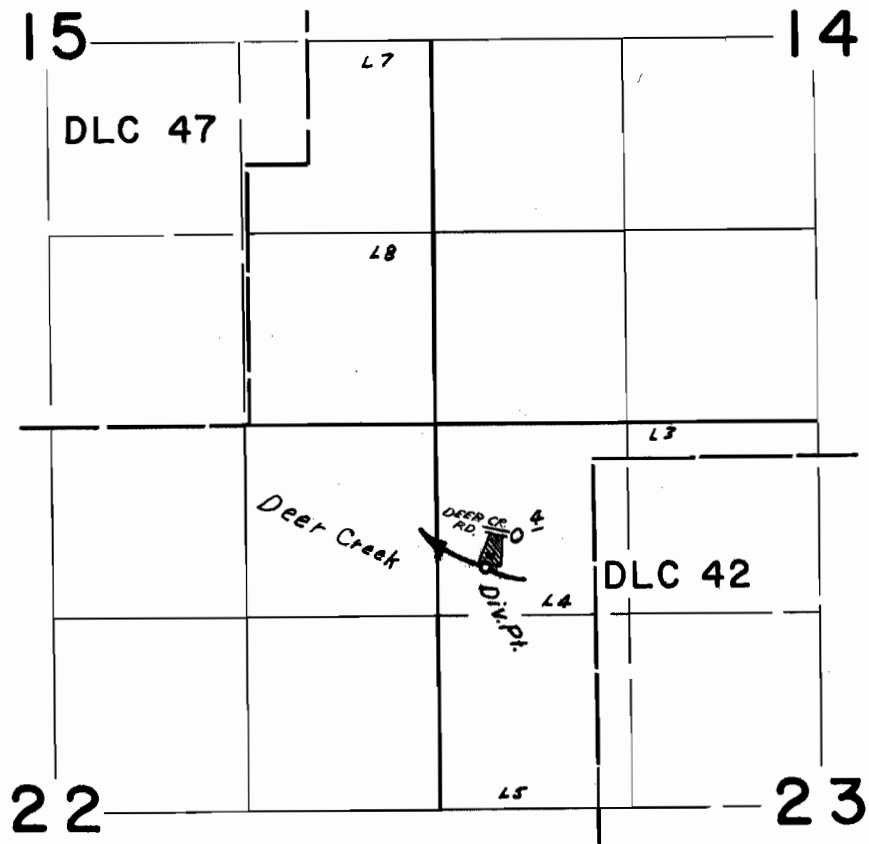

FINAL PROOF SURVEY
UNDER

Application No. 38708... Permit No. 28824...
IN NAME OF

JACK SNOW & JEAN LOUISE SHELDON

Surveyed July 14, 1964, by C.W. Gardner