


T. 26 S. R. 4 W. W.M.

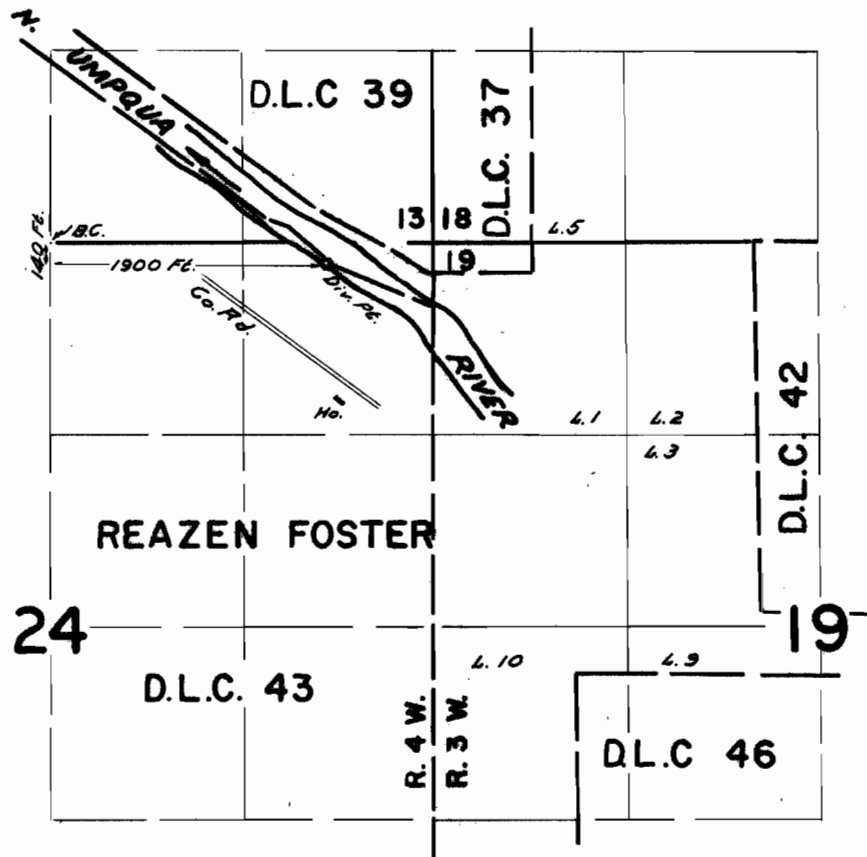

**FINAL PROOF SURVEY**  
UNDER

Application No. 39667 Permit No. 29529  
IN NAME OF

SAMUEL J. & ELLEN STREET

Surveyed OCT. 26 1965, by L. COLEBANK