



T. 33 S. R. 29 E. W. M.

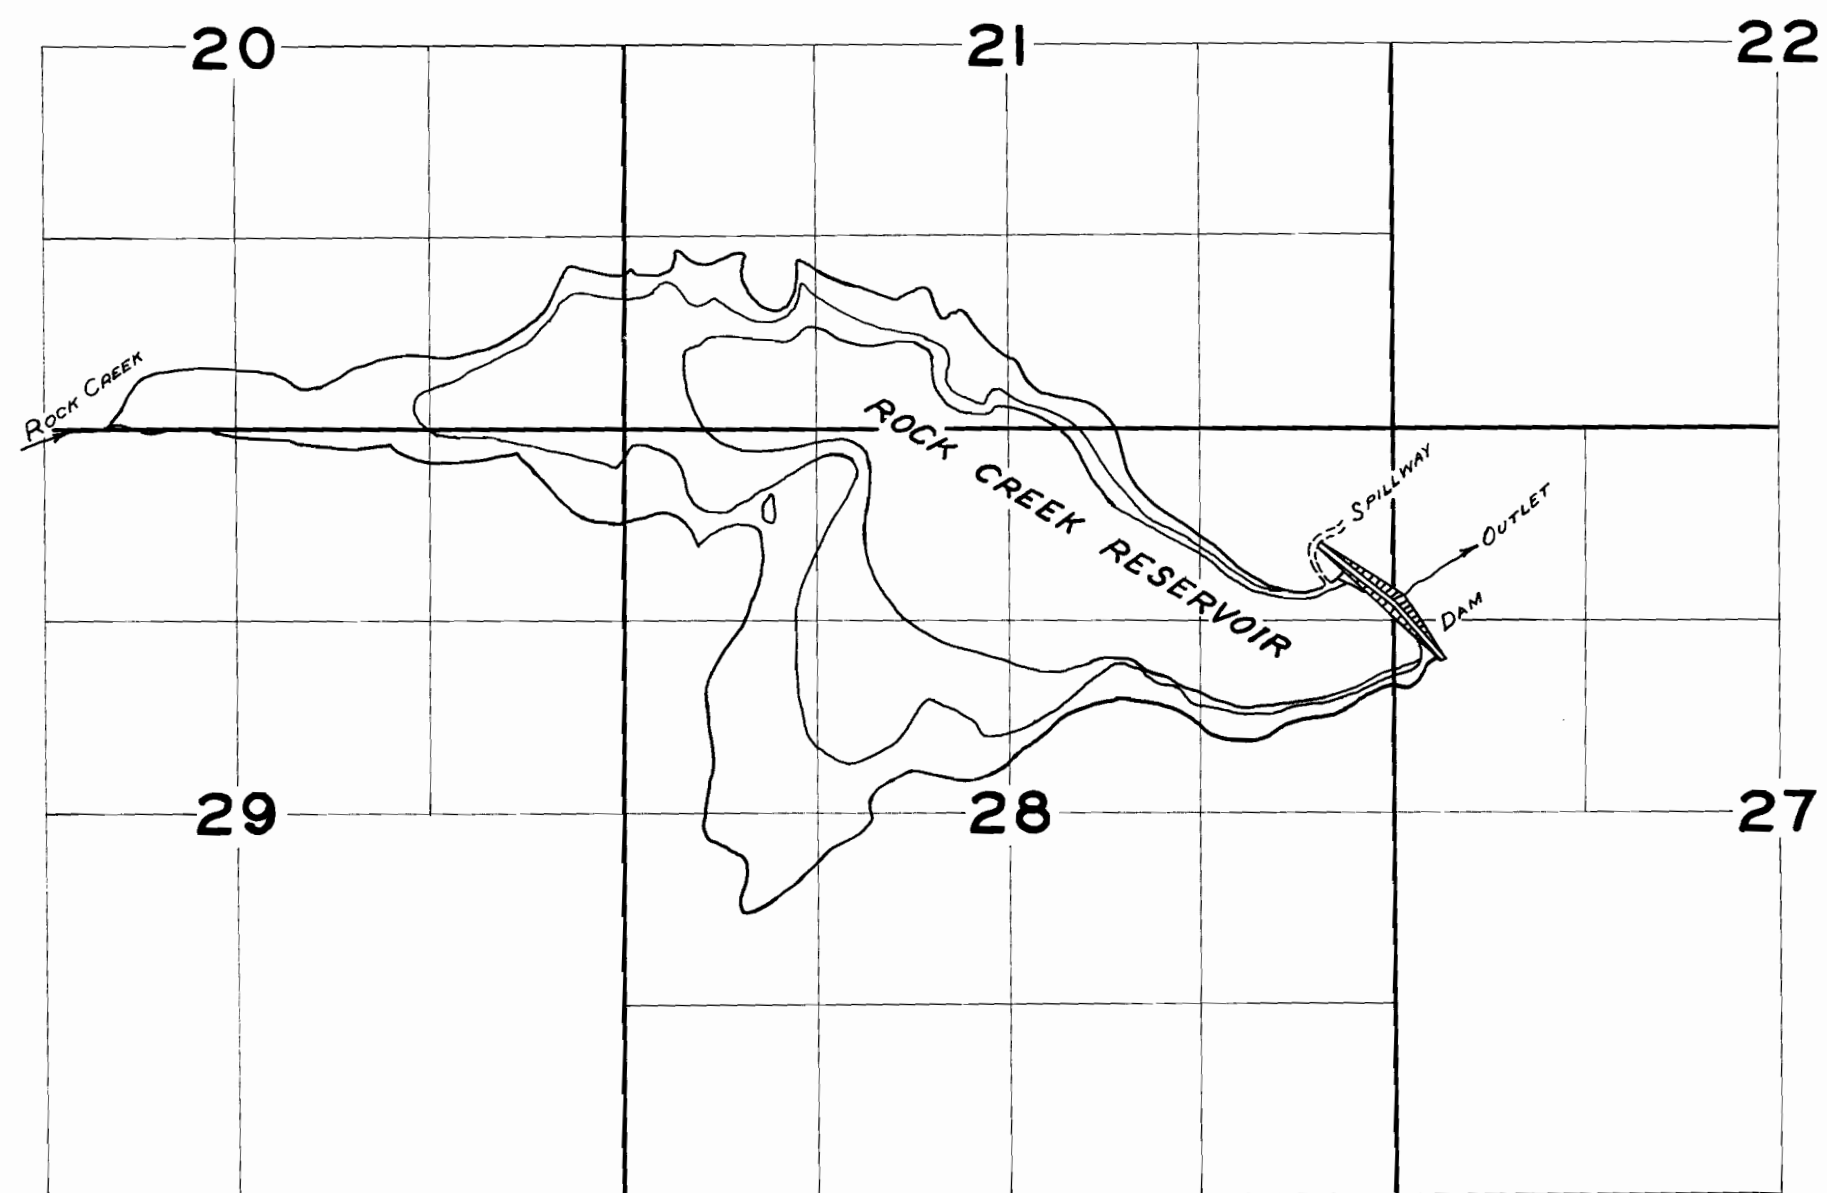

T. 33 S. R. 30 E. W. M.

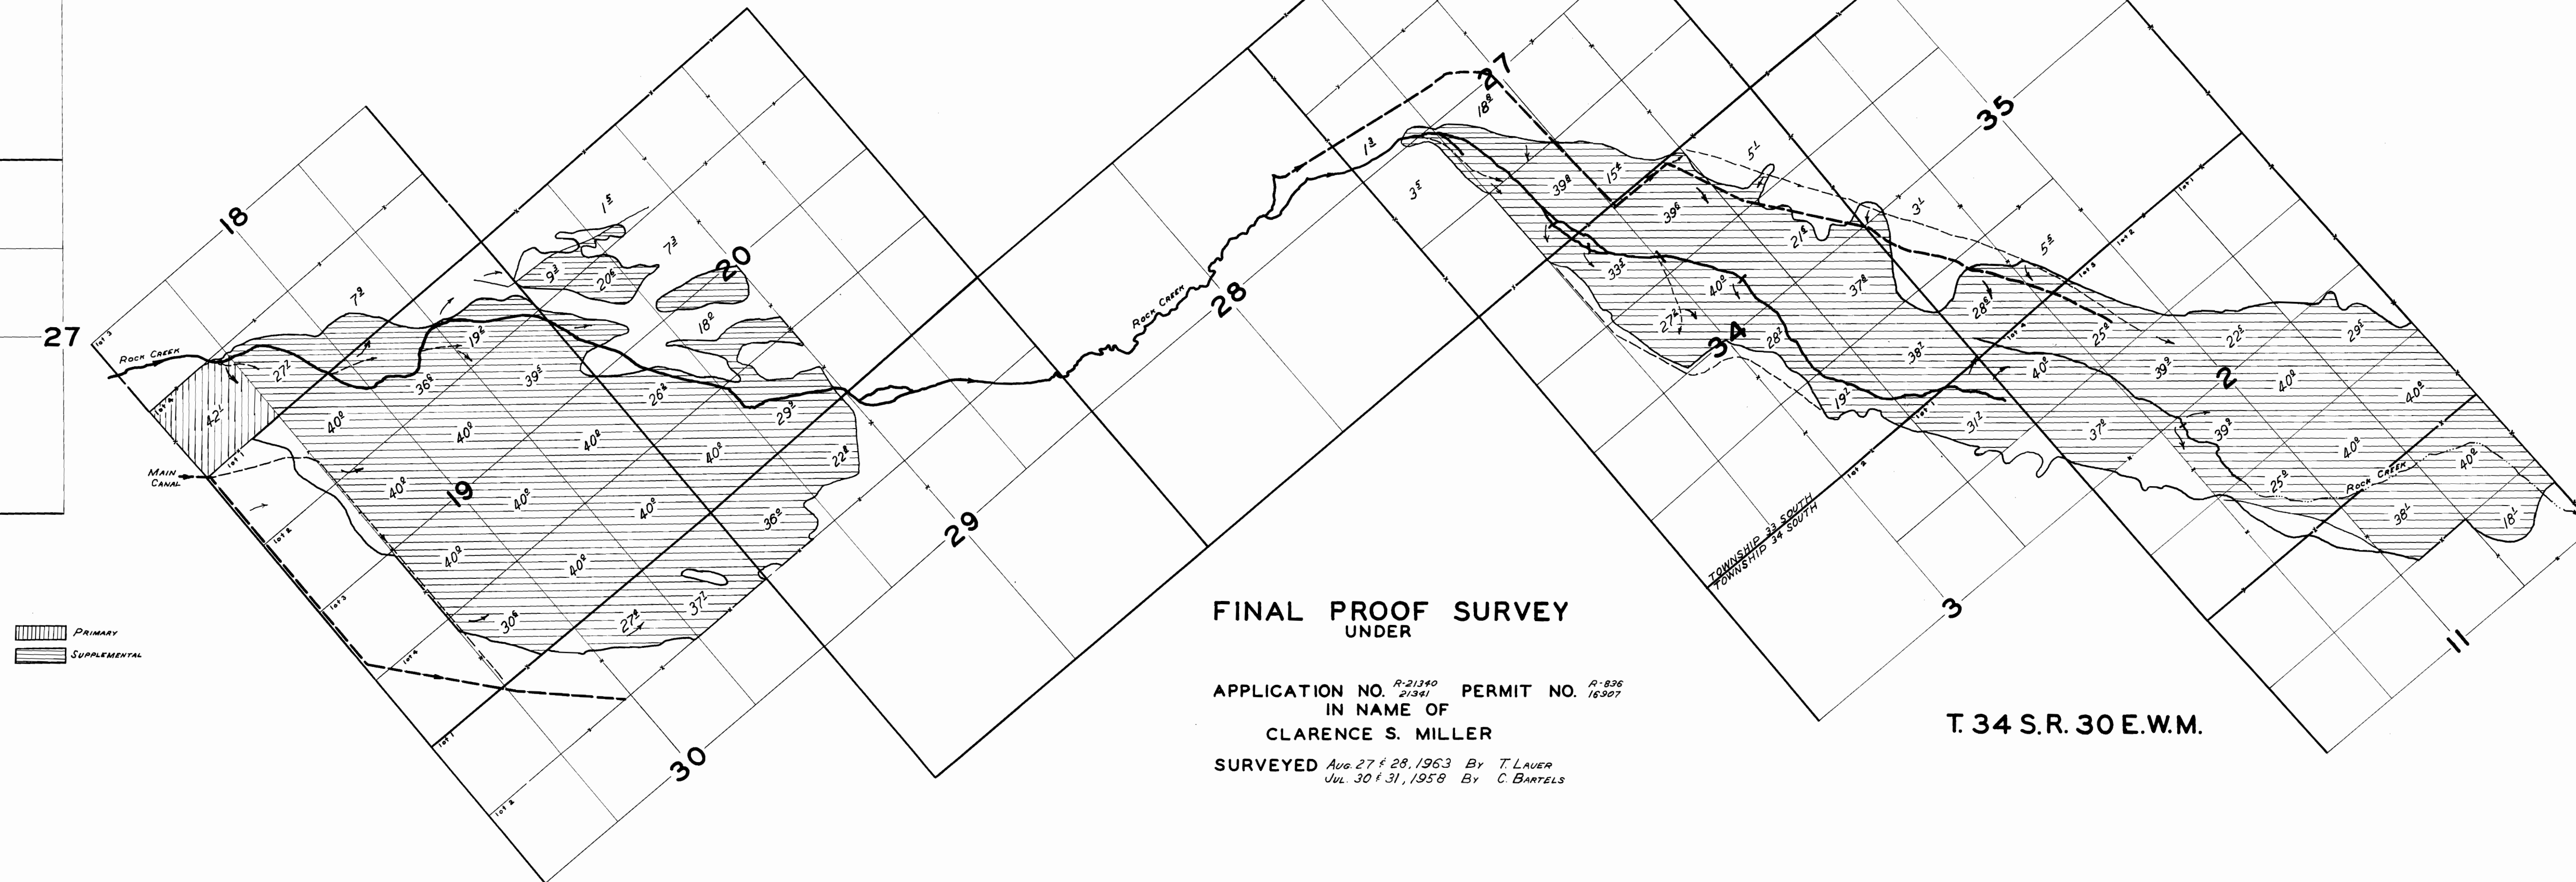

FINAL PROOF SURVEY UNDER

APPLICATION NO. ^{R-21340} 21341 PERMIT NO. ^{R-836} 16307
IN NAME OF
CLARENCE S. MILLER

SURVEYED AUG. 27 & 28, 1963 BY T. LAUER
JUL. 30 & 31, 1958 BY C. BARTELS

T. 34 S. R. 30 E. W. M.