


T. 36S. R. 4 & 5 W. W.M.

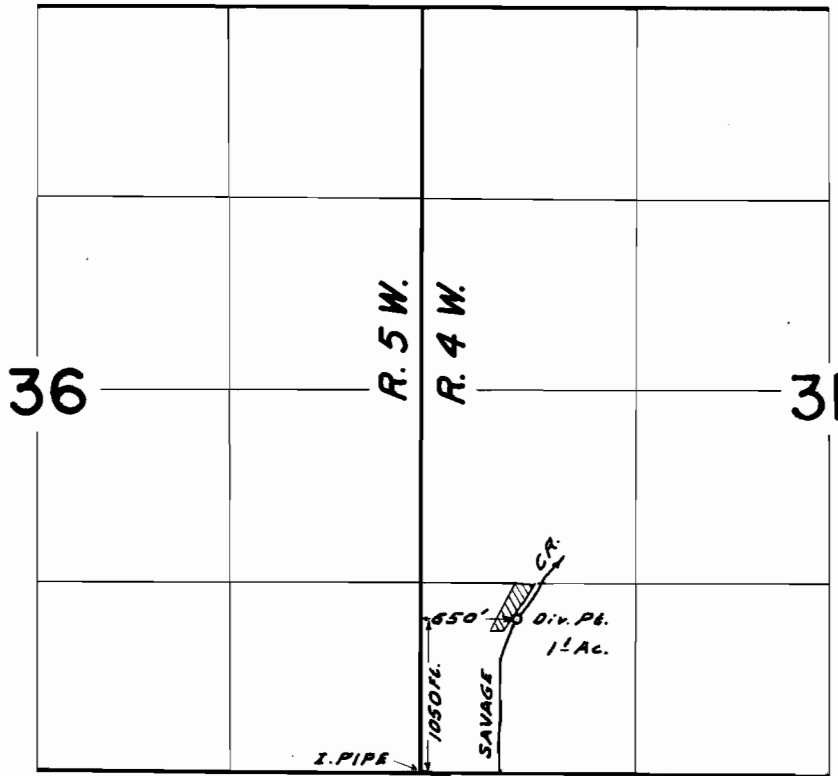

FINAL PROOF SURVEY
UNDER

Application No. 38994 Permit No. 29048
IN NAME OF

RALPH S. & LIBBY W. DODGE

Surveyed JULY 20 1965, by L. COLEBANK