


T. 34 S. R. 4 W. W.M.

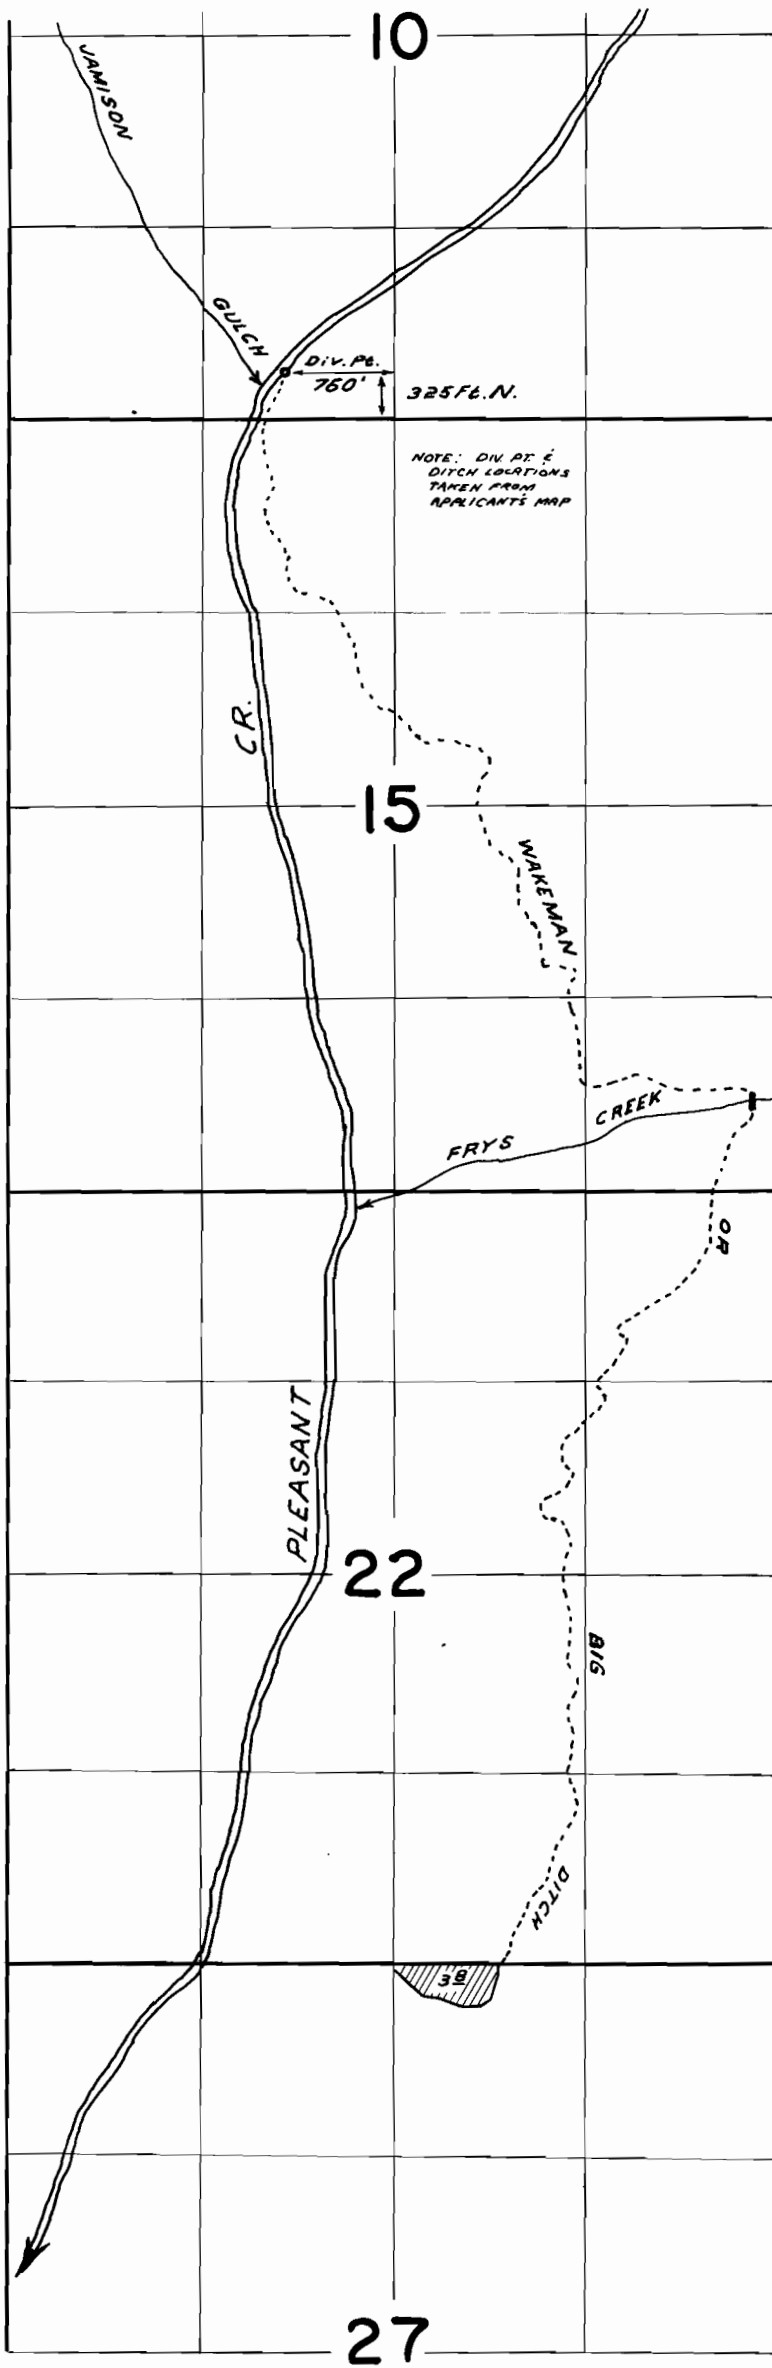

FINAL PROOF SURVEY

Application No. 33079 Permit No. 26158

IN NAME OF

HUGH ELLIS

Surveyed JUNE 25 1965, by L. COLEBANK