


T. 40 S. R. 2 E. W. M.

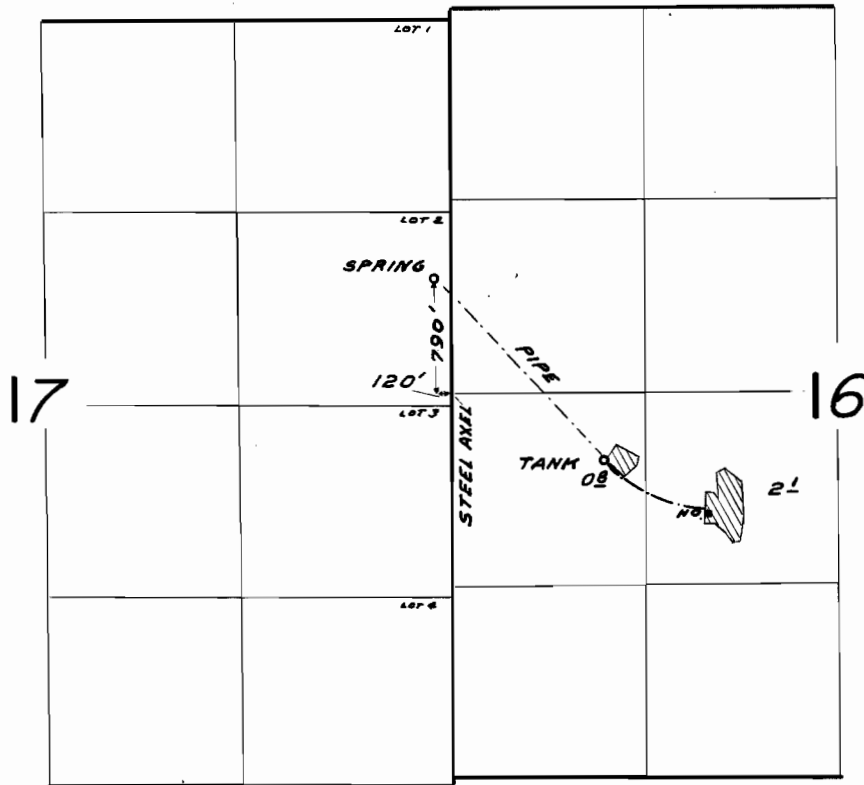

FINAL PROOF SURVEY
UNDER

Application No. 32850 Permit No. 25949
IN NAME OF

ROBERT N. & MARIE E. FORD

Surveyed JUNE 23 1965, by L. COLEBANK