


T. 35S. R.2.W. W.M

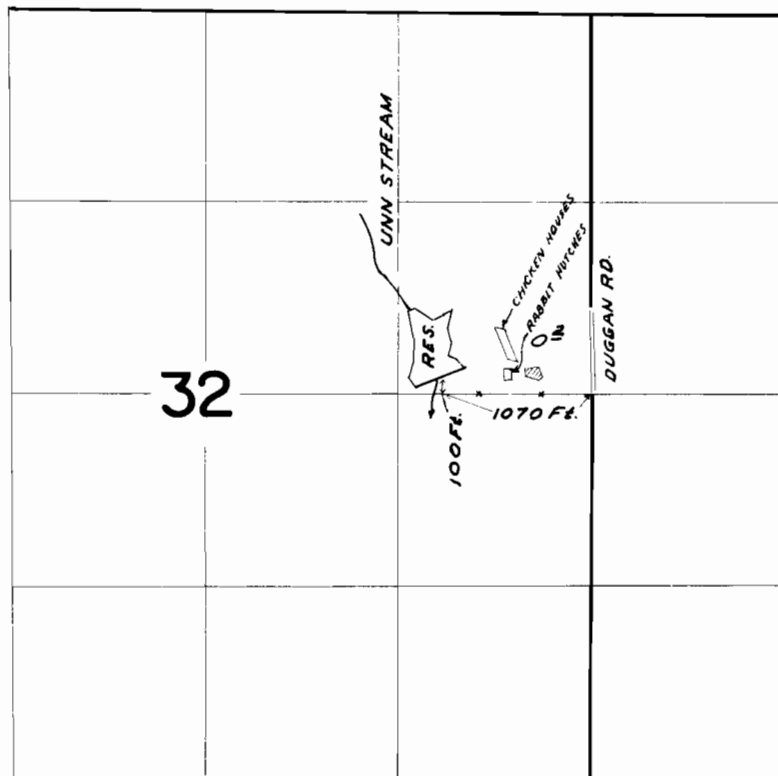

FINAL PROOF SURVEY
UNDER

R-34386

R-2515

Application No. 34387 Permit No. 27018
IN NAME OF

E. J. KORNER

Surveyed JUNE 24, 1965, by L. COLEBANK