


T.35S. R.2W. W.M.

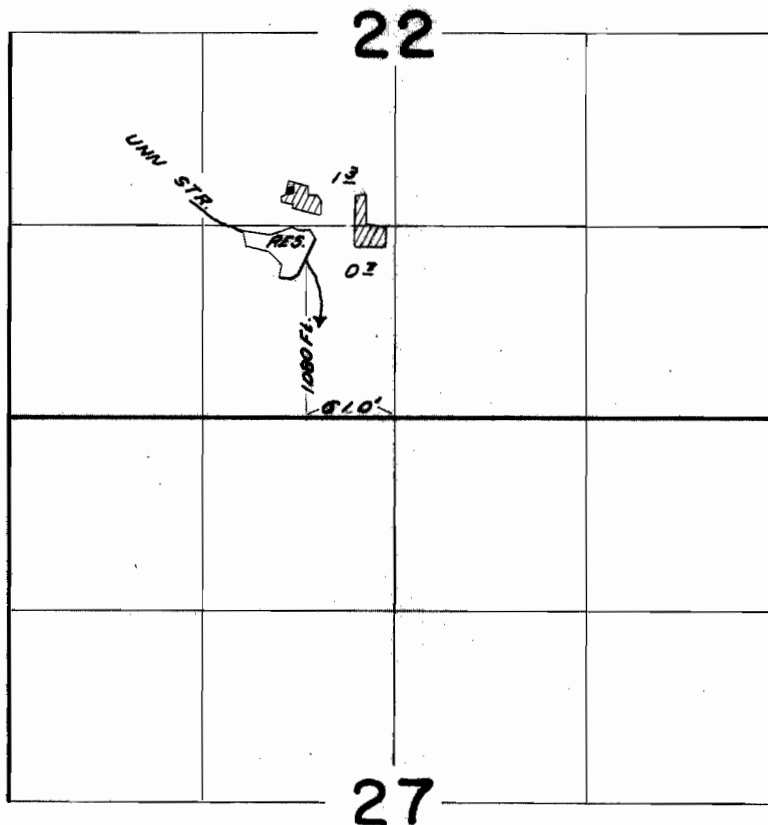

FINAL PROOF SURVEY
UNDER

R-34422

R-2518

Application No. 34423 Permit No. 27037
IN NAME OF

FRANK LAMBRECHT

Surveyed JUNE 24 1965 by L. COLEBANK