


T. 36S. R. 3W. W.M.

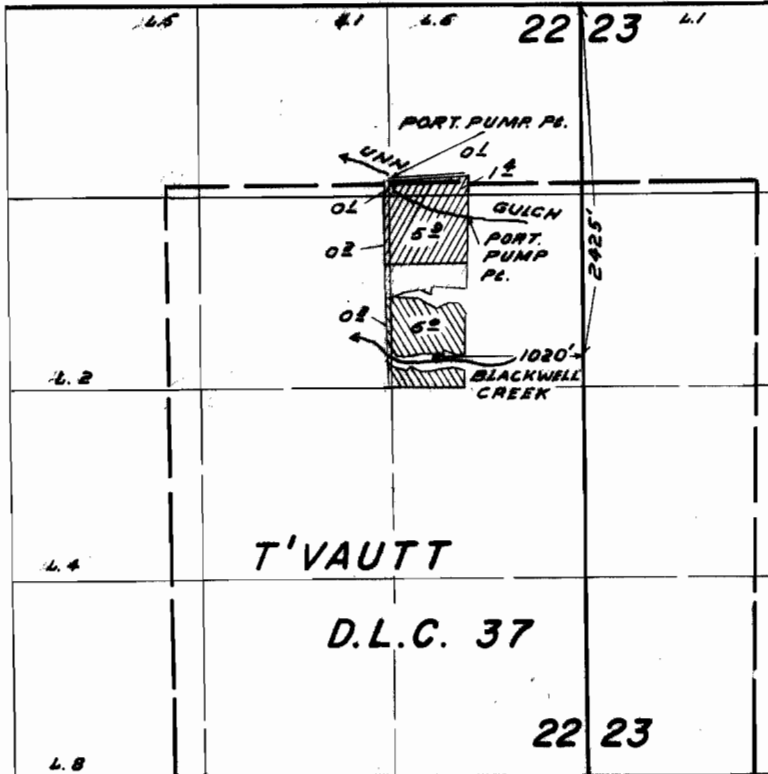

PORTABLE PUMPING PLS. 1220 FT. S & 1300 FT. W FROM N.E. COR. SEC. 22
1480 FT. S & 780 FT. W

FINAL PROOF SURVEY
UNDER

Application No. 34151 Permit No. 26932
IN NAME OF

MRS. MARVIN R. McDOLE

Surveyed JUNE 29 1965, by L. COLEBANK