


T.37 S. R.2W. W.M.

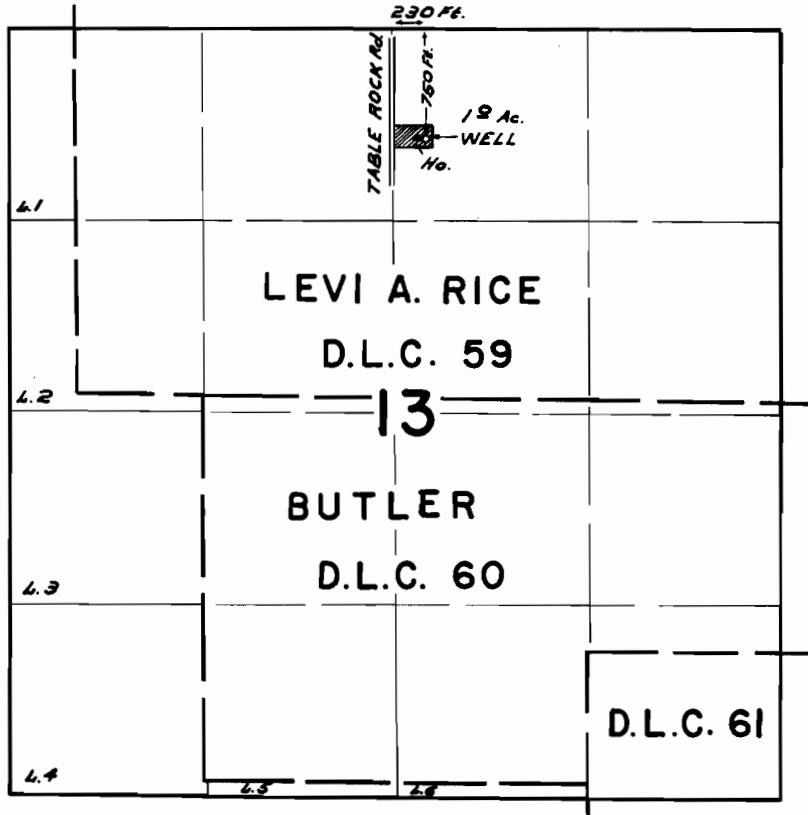

FINAL PROOF SURVEY
UNDER

Application No. G-2658 Permit No. G-2465
IN NAME OF

RALPH R. RAYMOND

Surveyed JUNE 28 1965, by L. COLEBANK