


T.34 S.R. 1 W.W.M.

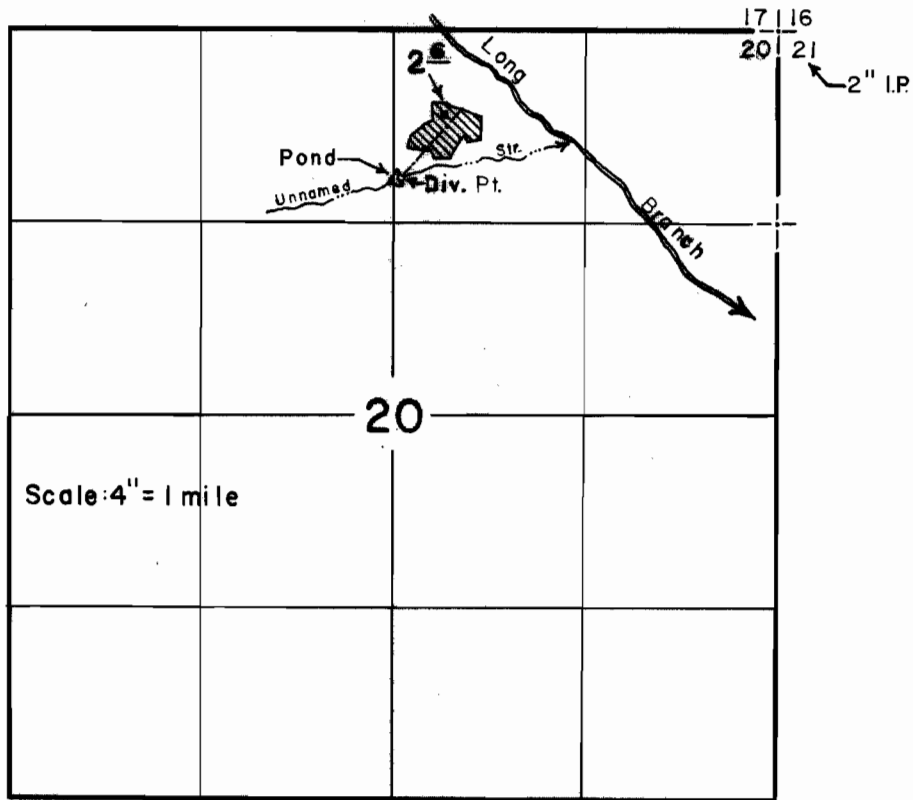

FINAL PROOF SURVEY UNDER

Application No. 35041..... Permit No. 27444.....
IN NAME OF

..... Joseph H. Rhodes

Surveyed Nov. 16..... 1966, by D.C. Hendrix.....