


T. 37 S. R. 2 W. W.M.

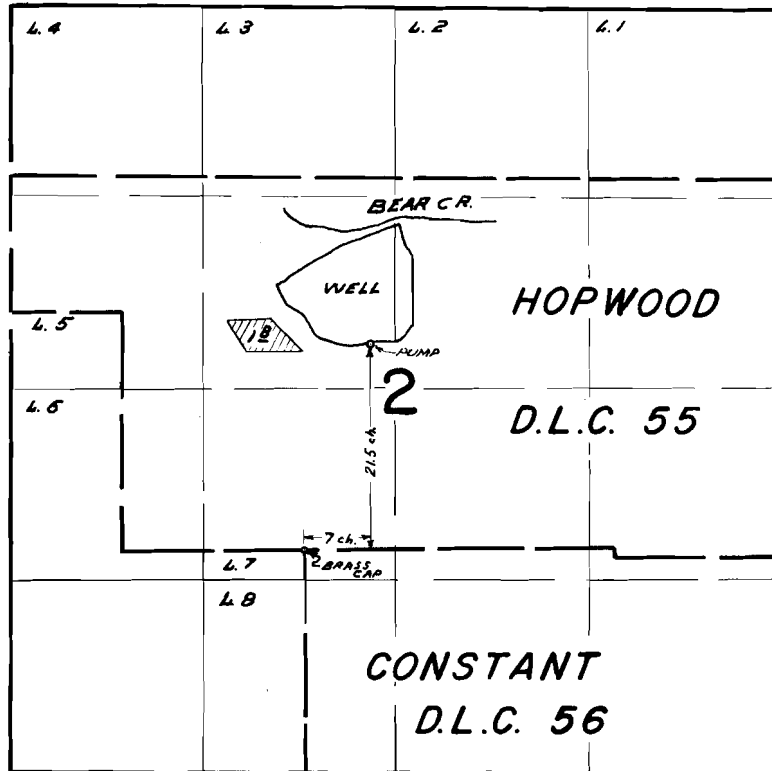

FINAL PROOF SURVEY
UNDER

Application No. G-2062 Permit No. G-1901
IN NAME OF

J. M. & LILLIAN C. WEIDMAN

Surveyed JUNE 20 1965, by L. COLEBANK