


T.34S.R.8E.W.M.

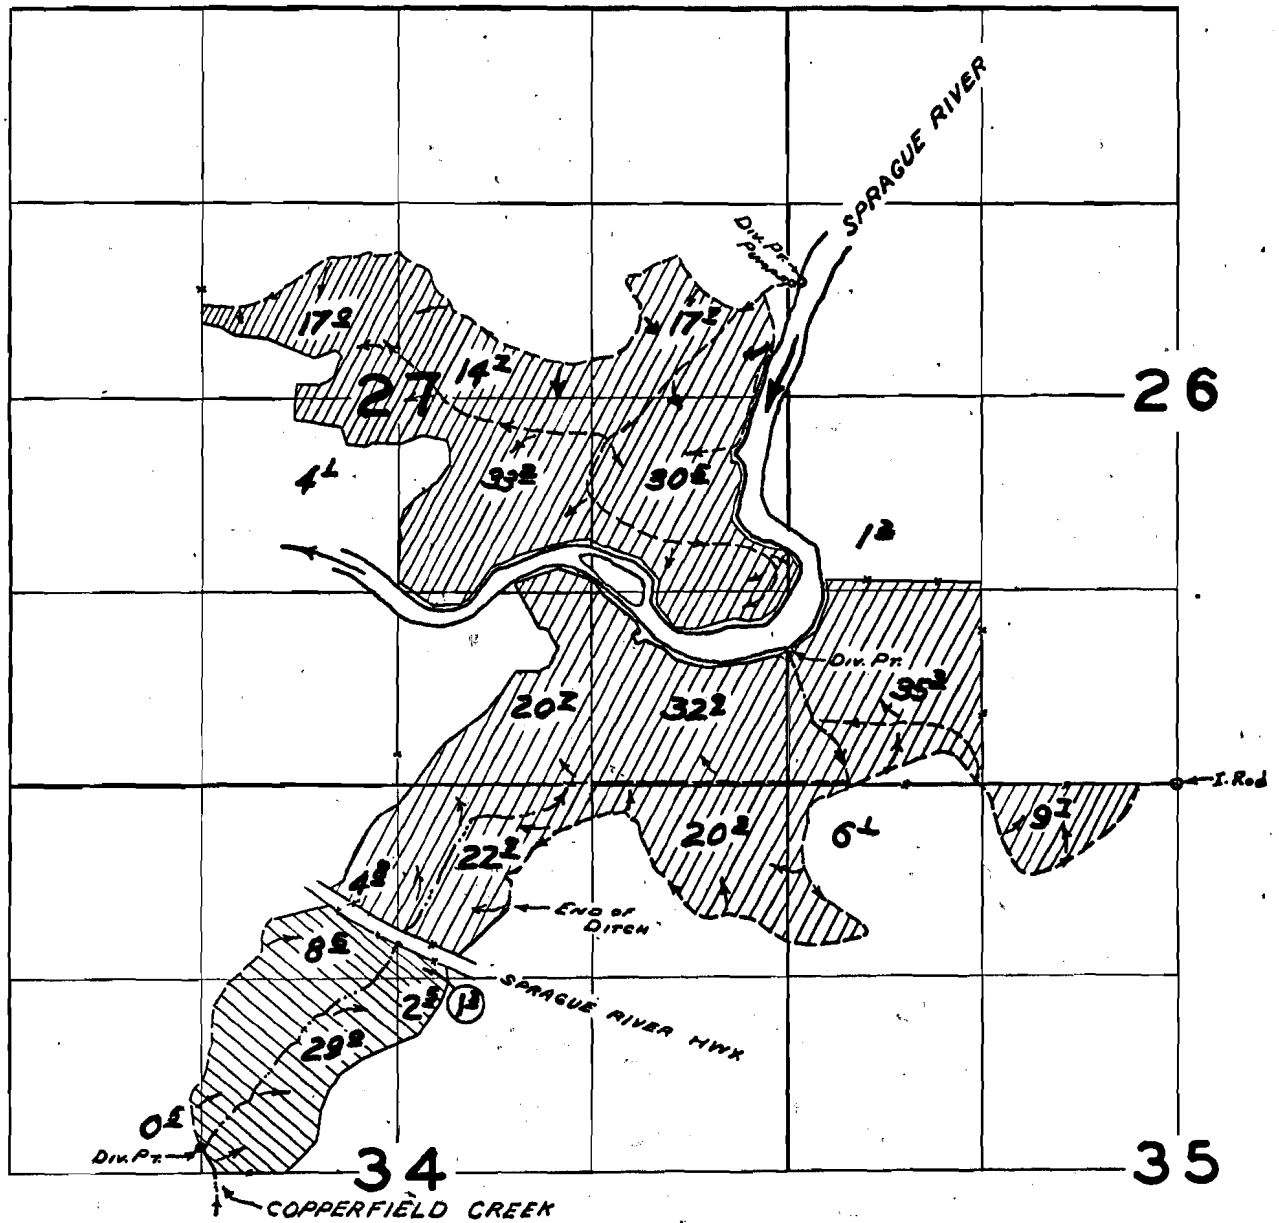

 SPRAGUE RIVER
 COPPERFIELD CREEK

FINAL PROOF SURVEY UNDER

Application No. 30319 Permit No. 23733
 IN NAME OF
ROBERT MOISIO
MARSHALL W. & DOROTHEA M. POOLE

Surveyed Aug 12 1964, by R. JACKSON