


T.36S.R.12 E.W.M.

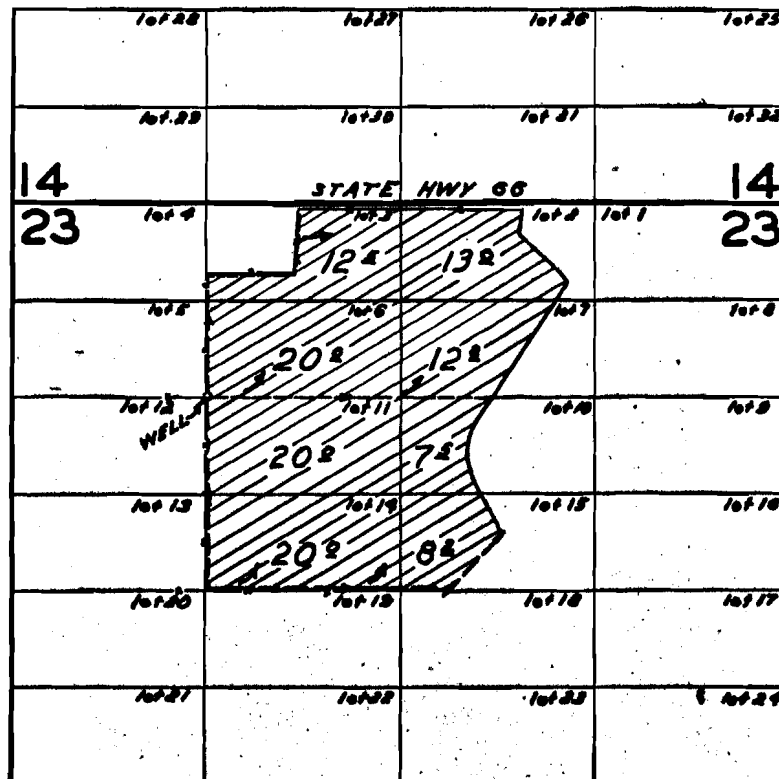

FINAL PROOF SURVEY

UNDER

Application No. G-274 Permit No. G-2051
IN NAME OF

J.L. & PATTY STEPHENS

Surveyed Aug 20 1964, by R. JACKSON