


T.16S. R.4 W. W.M.

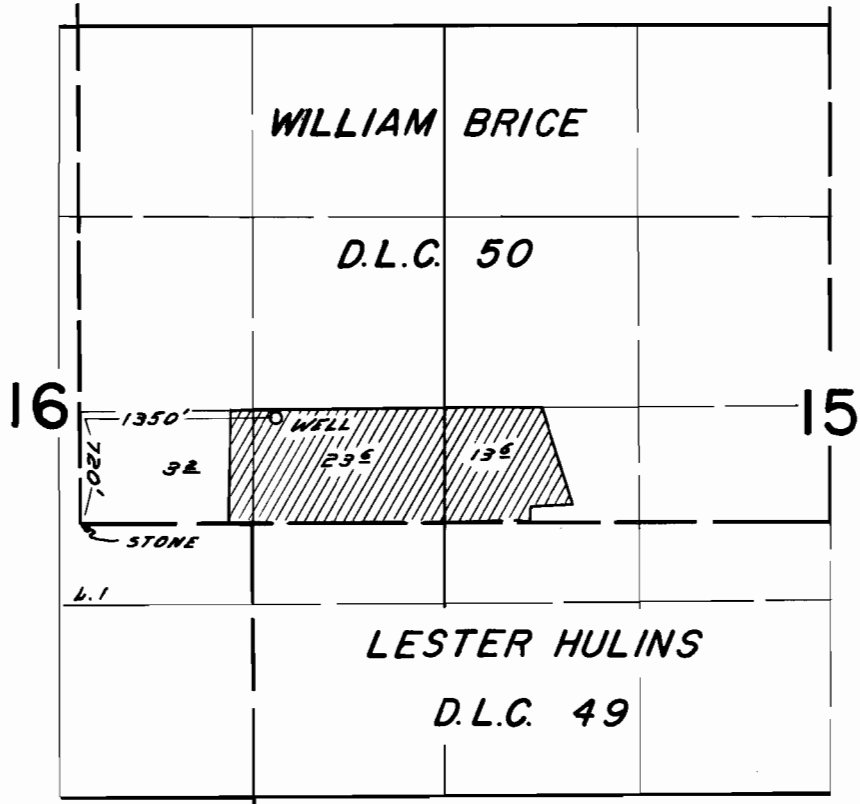

**FINAL PROOF SURVEY**  
UNDER

Application No. G-2339 Permit No. G-2159  
IN NAME OF

GEORGE HARPER

Surveyed APR 27 1965, by L. COLEBANK