



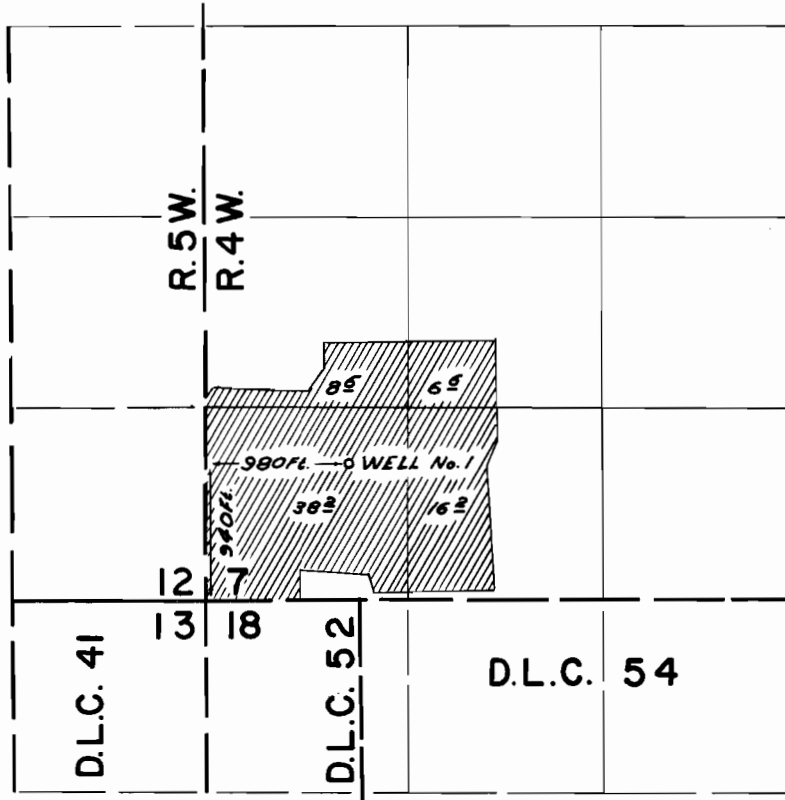

FINAL PROOF SURVEY
UNDER

Application No. G-2590 Permit No. G-2416
IN NAME OF

EARL C. & RAYMOND JAGER

Surveyed APR. 29 1965, by L. COLEBANK