


T.15S. R.4&5W. W.M.

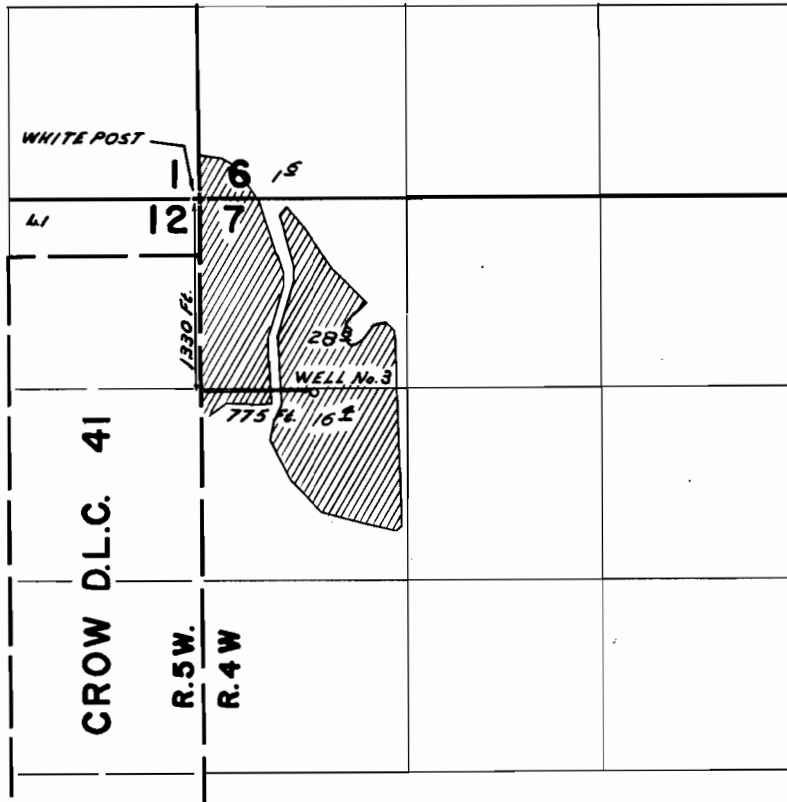

FINAL PROOF SURVEY
UNDER

Application No. 6-2592 Permit No. 6-2418
IN NAME OF

EARL C. & RAYMOND JAGER

Surveyed APR. 29 1965, by L. COLEBANK