


# T. 17 S. R. 3 W. W. M.

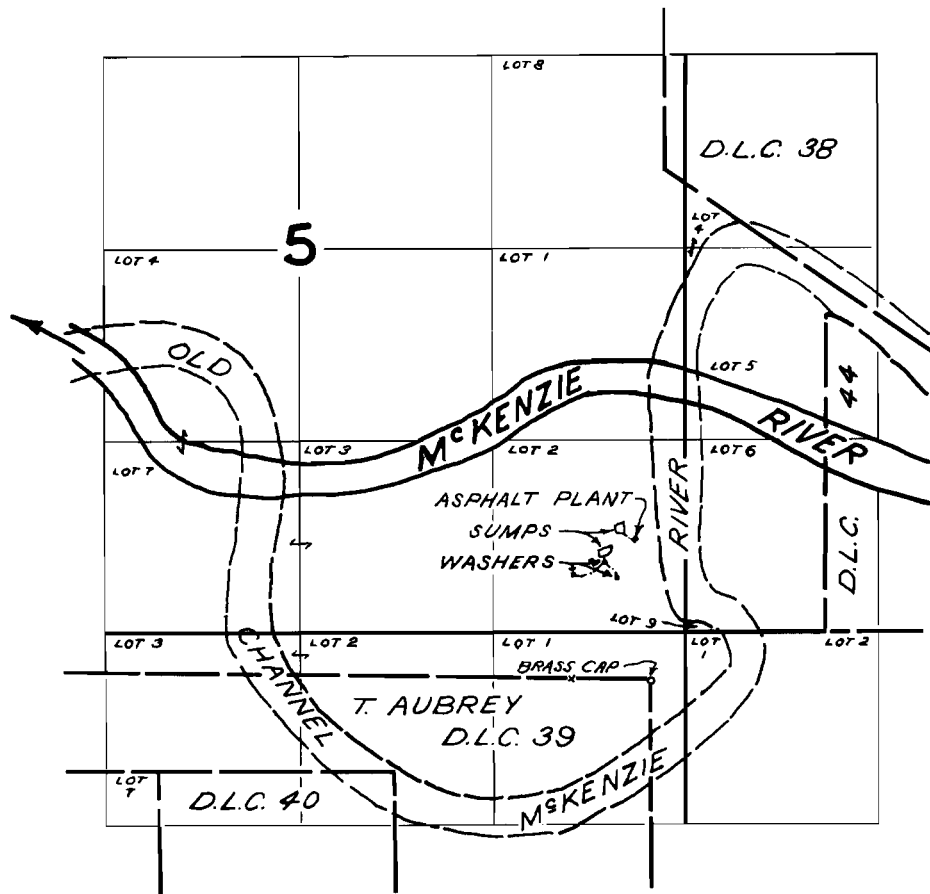

## FINAL PROOF SURVEY UNDER

Application No. 38315 Permit No. 28631

IN NAME OF  
**MCKENZIE SAND & GRAVEL CO.  
& MCKENZIE ASPHALT CO.**

Surveyed MAY 4 1964, by R. JACKSON