


T.20S. R.4W. W.M.

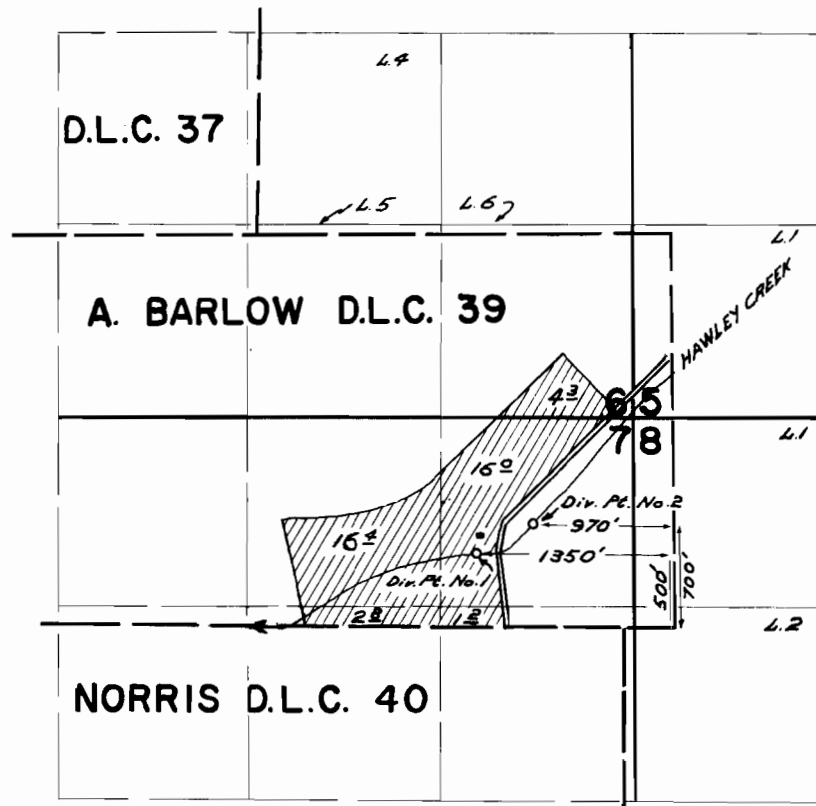

FINAL PROOF SURVEY

UNDER

Application No. 25802 Permit No. 24207
IN NAME OF

EVA E. PURDY & SONS

Surveyed APR. 25 1962, by C. BAKER.....