


5

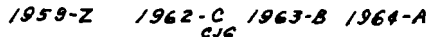

UNDER


IN NAME OF

C.R. Baker

T. Lauer

R. Jackson

T.18 S.R.6W.W.M

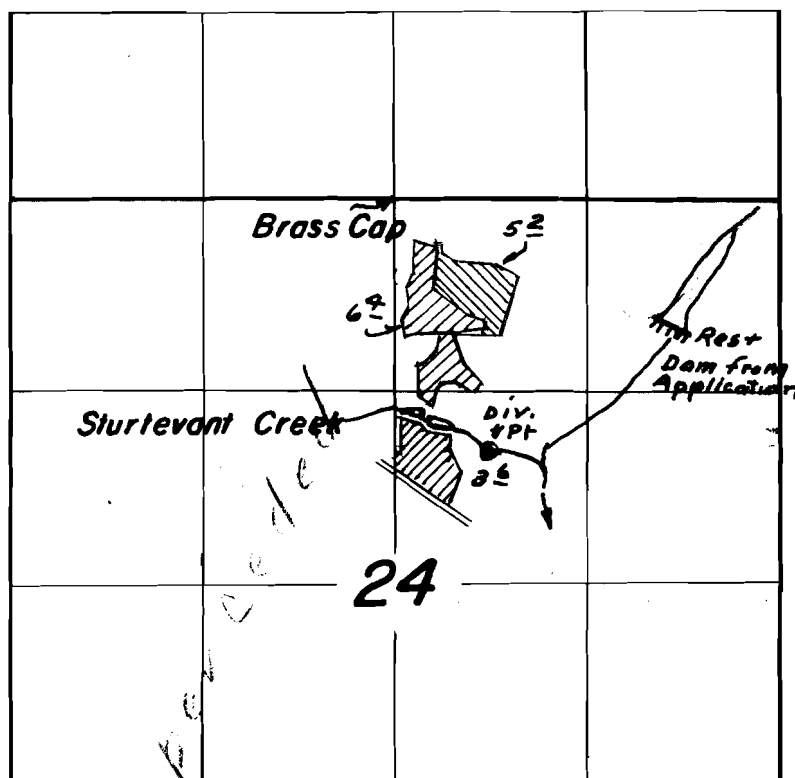

Primary



Supplemental


FINAL PROOF SURVEY
UNDER

R-34018 R-2453
Application No. 34080 Permit No. 26877
IN NAME OF

William Schoren

Surveyed May 9, 1962, by Carl R. Baker

T. 18S. R. 6 W.W.M.

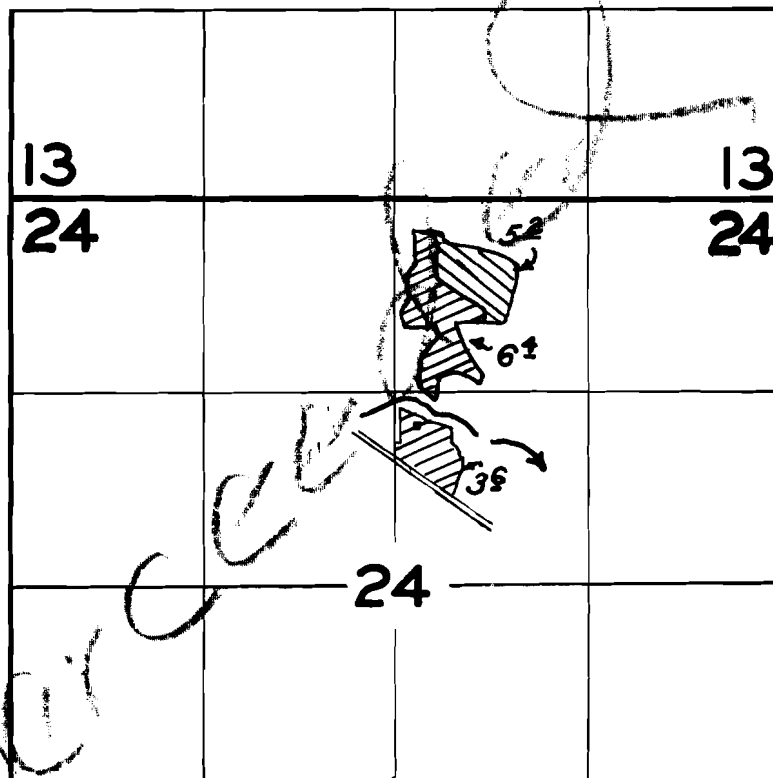

 *Primary*
 *Supplemental*

FINAL PROOF SURVEY
UNDER

Application No. *R-34018* *34080* Permit No. *R-2453* *26877*
IN NAME OF

William Scharen

Surveyed *2 May* 1962, by *Carl R. Baker*