
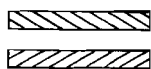


T.18S.R.6W. W.M.

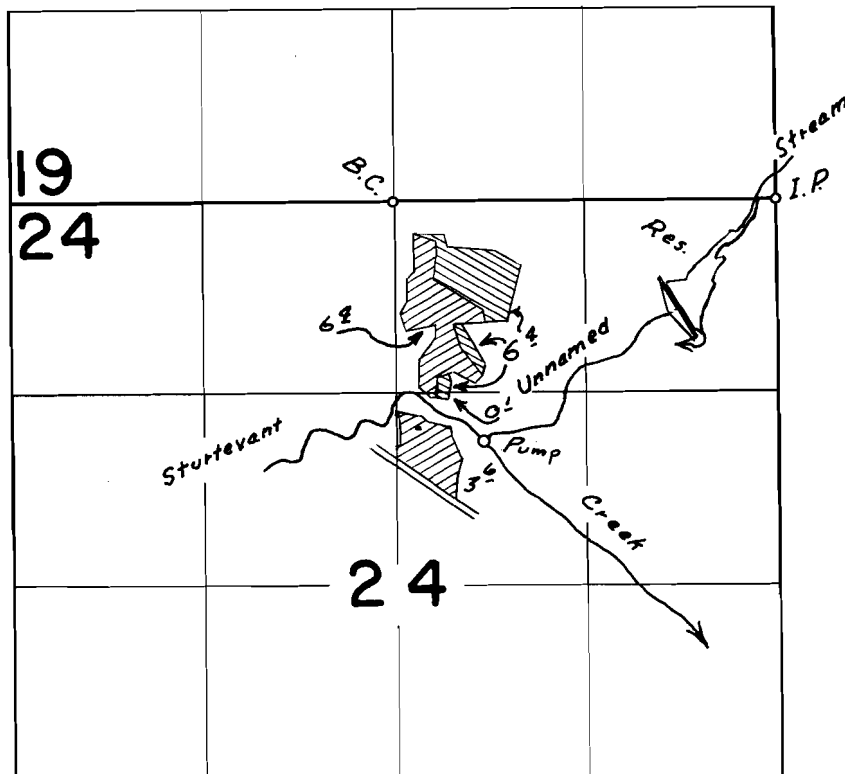

Primary

Supplemental

FINAL PROOF SURVEY UNDER


34080 26877
Application No. R-34018. Permit No. R-2453.
IN NAME OF

WILLIAM SCHAREN

Surveyed March 26, 1959, by C.O. Bartels
May 9, 1962 C.R. Baker
June 25, 1963 T. Lauer
May 6, 1964 R. Jackson

1959-Z 1962-C 1963-B 1964-A
CJC

T.18 S.R.6W.W.M

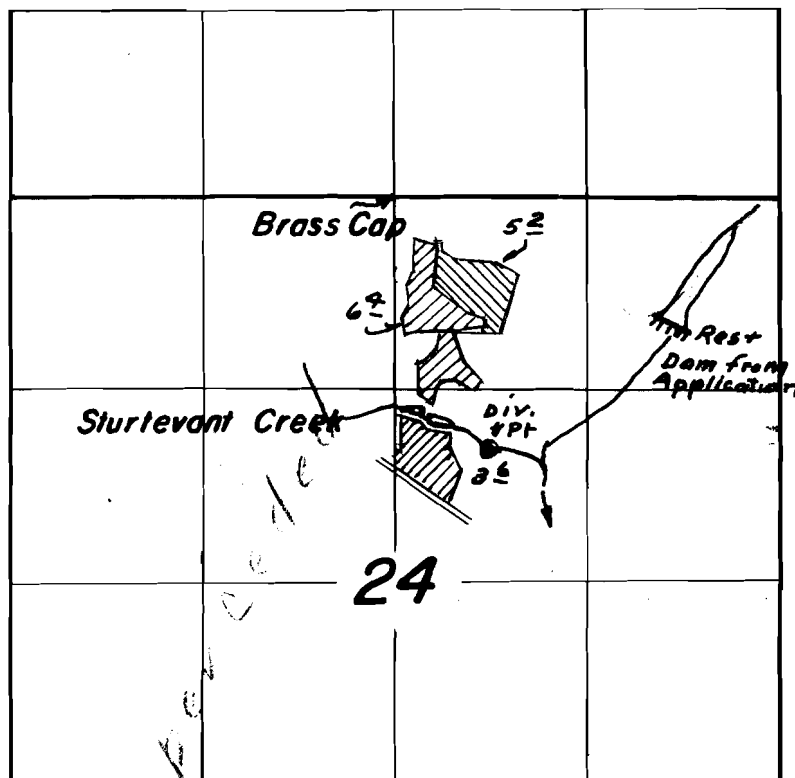

Primary



Supplemental


FINAL PROOF SURVEY
UNDER

R-34018 R-2453
Application No. 34080 Permit No. 26877
IN NAME OF

William Schoren

Surveyed May 9 1962, by Carl R. Baker

T. 18S. R. 6 W.W.M.

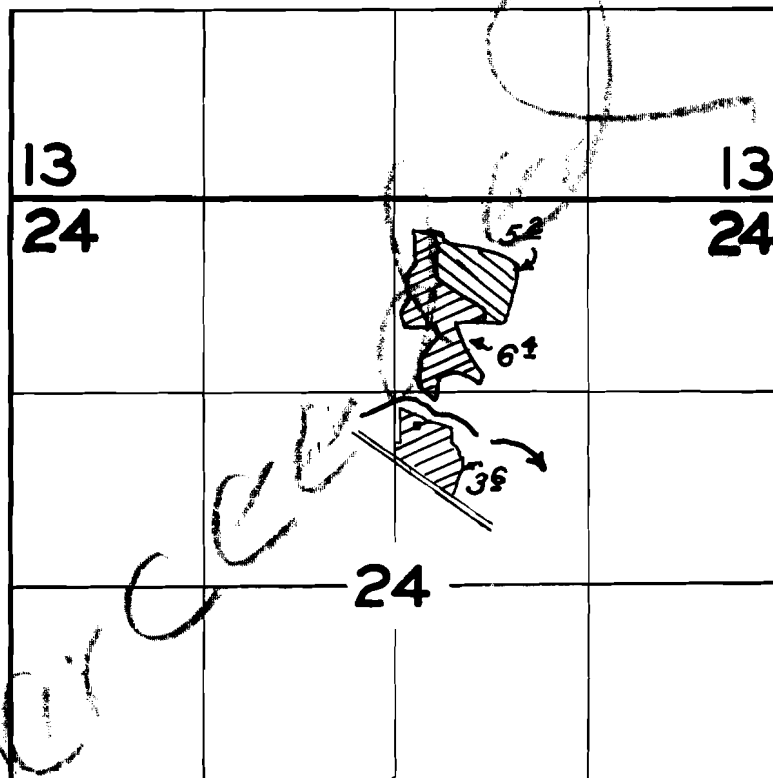

 *Primary*
 *Supplemental*

FINAL PROOF SURVEY
UNDER

Application No. *R-34018* *34080* Permit No. *R-2453* *26877*
IN NAME OF

William Scharen

Surveyed *2 May* 1962, by *Carl R. Baker*