


T. 7S.R.10W.W.M.

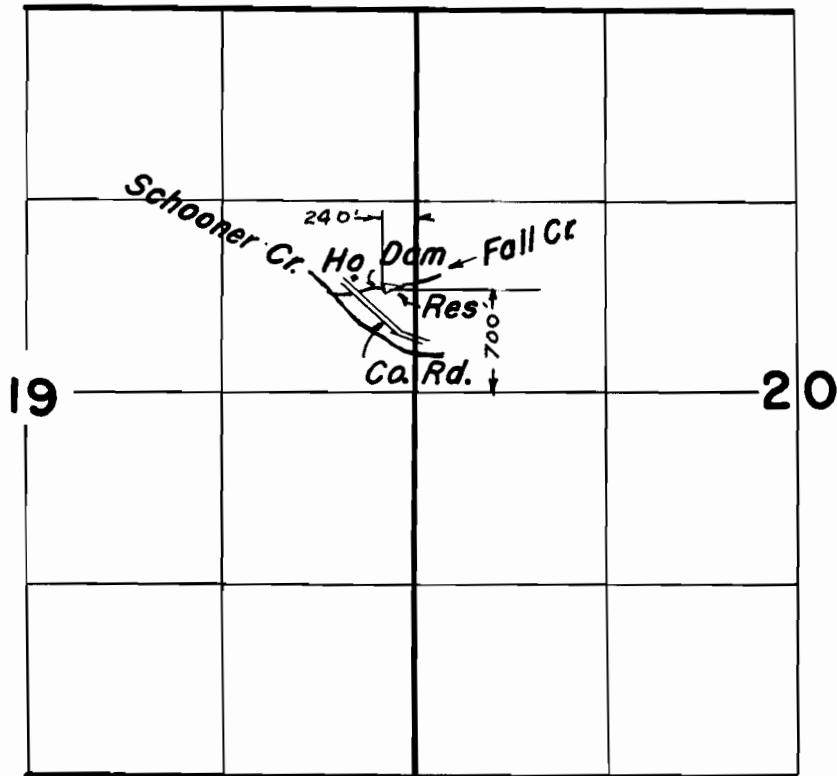

FINAL PROOF SURVEY
UNDER

Application No. *R-37019* Permit No. *R-2660*
IN NAME OF

Elmer Liswig

Surveyed *Oct. 15* 1965, by *F. Siegmund*