


T.12S.R.2W.W.M.

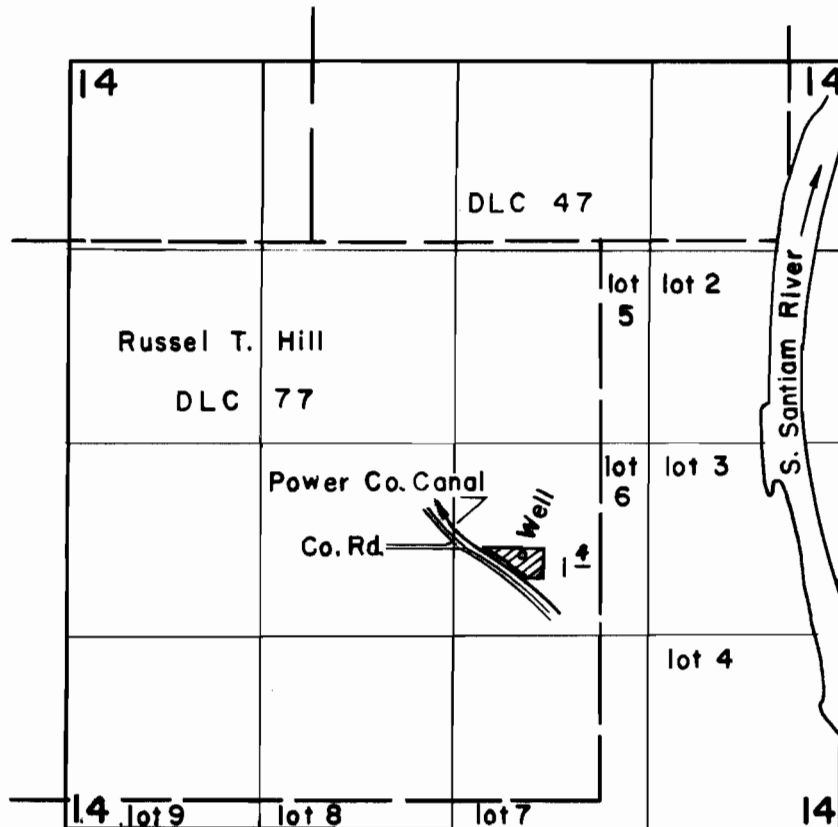

FINAL PROOF SURVEY
UNDER

Application No. G-1862 Permit No. G-1704
IN NAME OF

John & Viola Viles

Surveyed Nov. 4, 1964, by R. Jackson