


T.15S. R.3W. W.M.

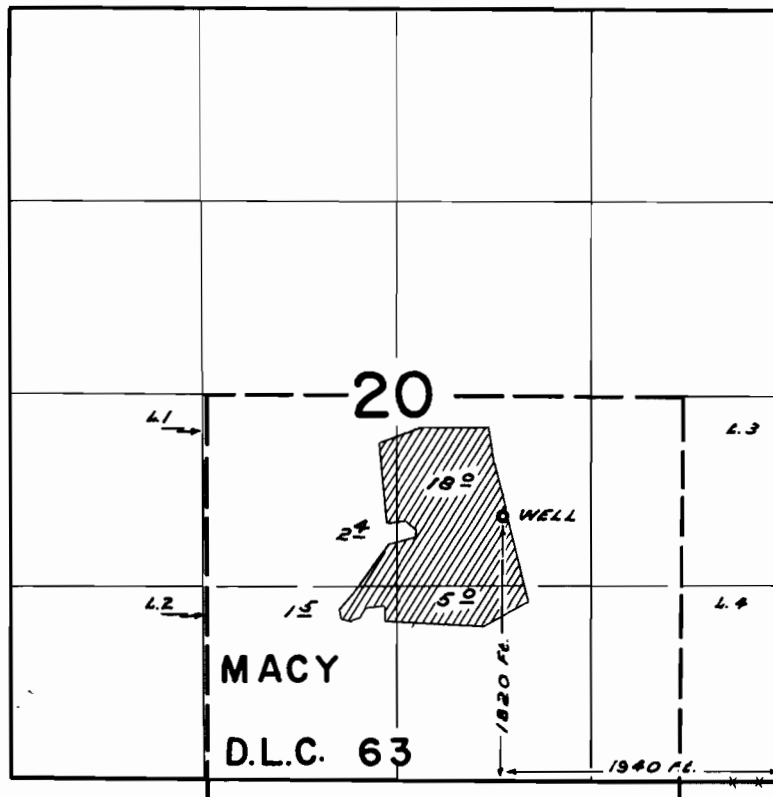

FINAL PROOF SURVEY
UNDER

Application No. G-2732 Permit No. G-2533
IN NAME OF

WALTER BOWERS

Surveyed SEPT 28 1965, by L. COLEBANK

1965-11-24