


T. 10S. R. 38 & 4W. W.M.


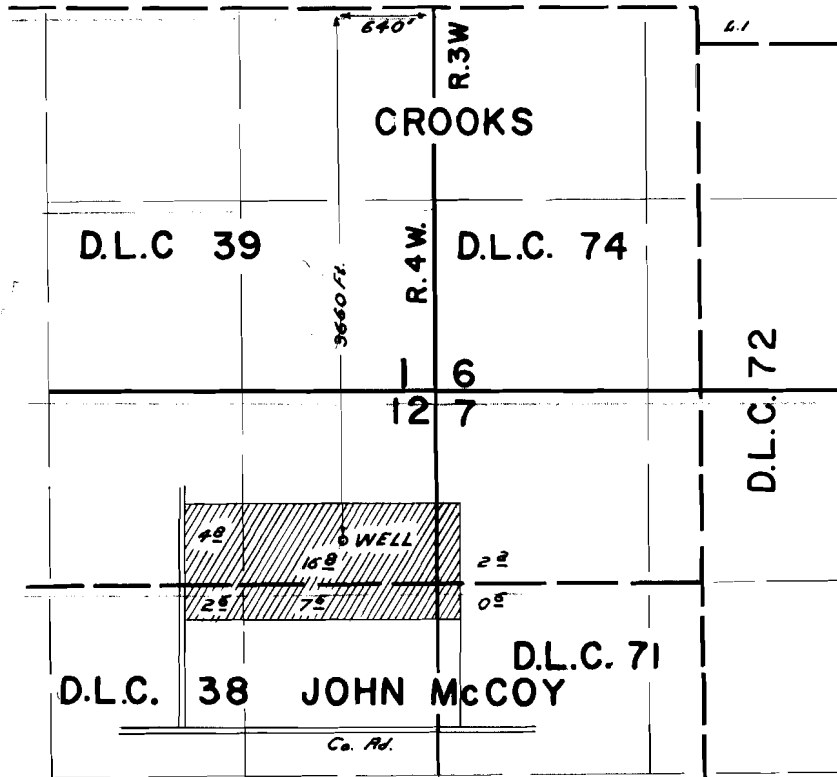

**FINAL PROOF SURVEY**  
 UNDER

Application No. G-2802 Permit No. G-2607  
 IN NAME OF

ELMER COOK & DALE CHILCOTE

Surveyed SEPT. 9 1965, by L. COLEBANK