


T. 10 S. R. 3 W. W.M.

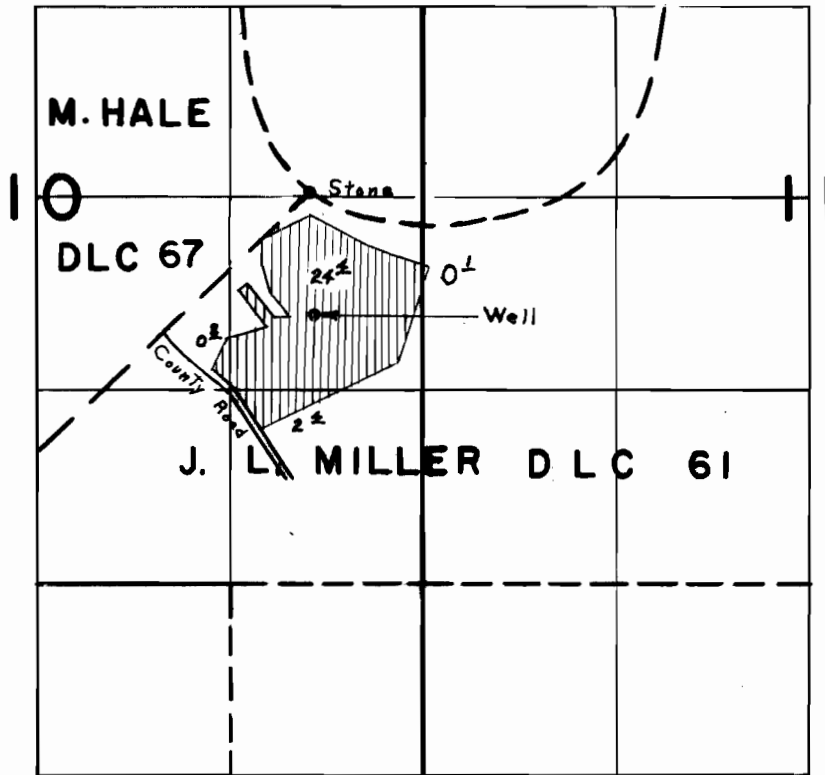

Well Located 840' S. & 50' E. From S. E. Corner DLC #67

FINAL PROOF SURVEY
UNDER

Application No. G-1860 Permit No. G-1702
IN NAME OF

..... RALPH KILLINGER

Surveyed May 6, 1966, by L. E. Gould.....