


T. 9 S. R. 1 W. W. M.

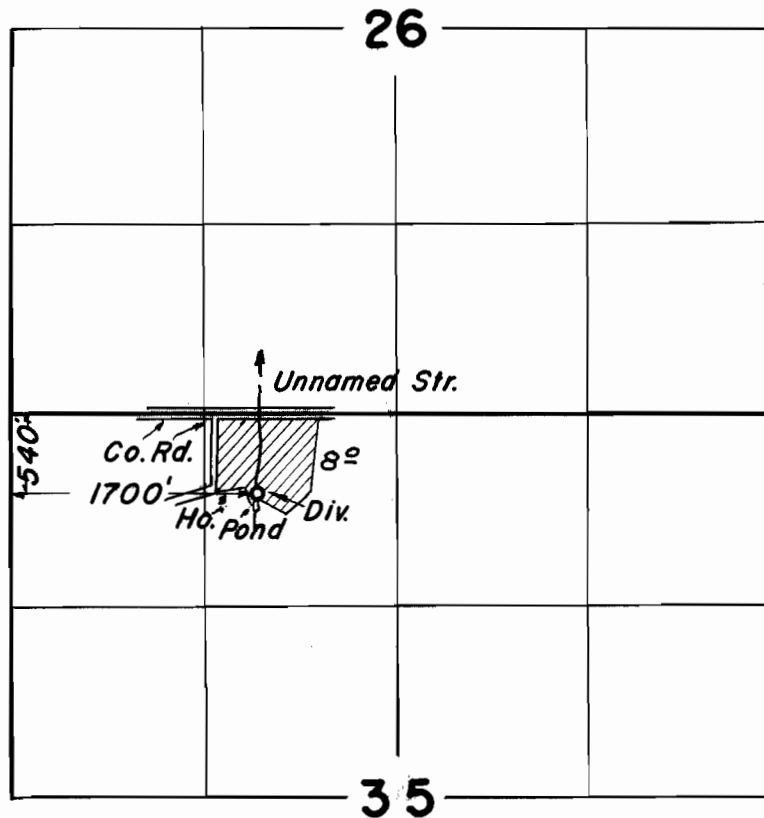

FINAL PROOF SURVEY
UNDER

Application No. 33923 Permit No. 27310
IN NAME OF

Anton J. Lackner

Surveyed June 3 1965, by F. Siegmund