


T. 10 S. R. 2 W. W. M.

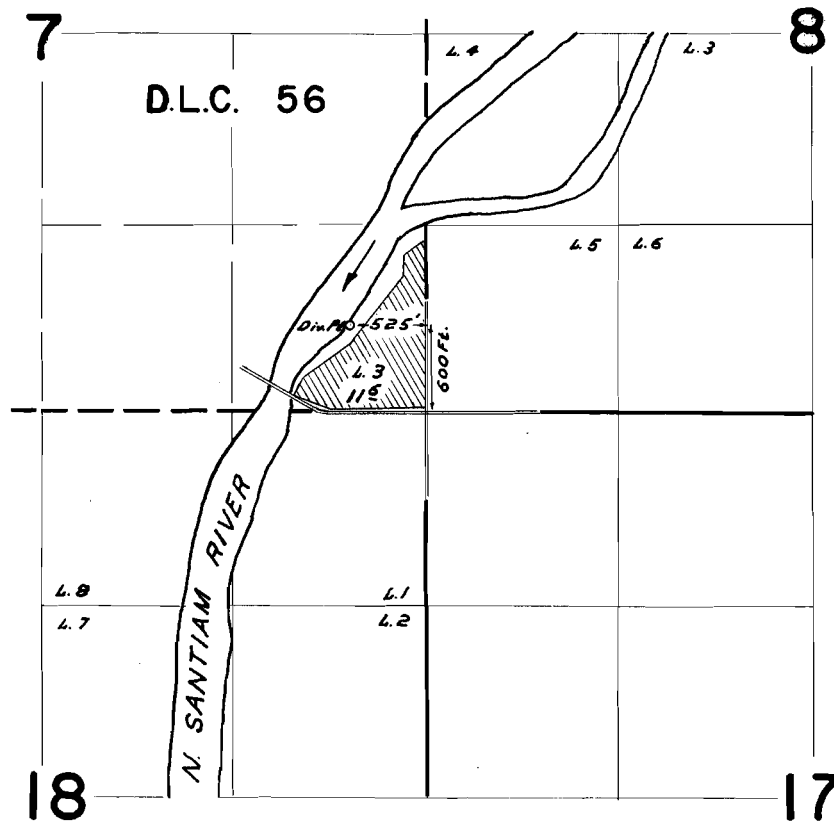

FINAL PROOF SURVEY
UNDER

Application No. 40162 Permit No. 29938
IN NAME OF

LESTER M. MALONE, SR.

Surveyed SEPT. 8 1965, by L. COLEBANK